

PHASE V EXPANSION

POST - CONSTRUCTION STORMWATER MANAGEMENT PLAN

Bethlehem Landfill Company

STORMWATER MANAGEMENT FACILITY MAINTENANCE NOTES

STORMWATER FACILITY OWNERSHIP

UPON COMPLETION OF THE PROJECT, THE OWNER WILL BE RESPONSIBLE FOR PERFORMING ANY PERIODIC OR ONGOING MAINTENANCE OF PERMANENT STORMWATER MANAGEMENT FACILITIES.

PERFORMANCE REQUIREMENTS

IF FOR ANY REASON THE DESIGNED FACILITIES OR CONTROL MEASURES DO NOT PERFORM AS REQUIRED, THE CONTRACTOR AND/OR OWNER SHALL ADJUST AND/OR MODIFY THE STORMWATER FACILITIES TO MEET THE APPLICABLE PERFORMANCE STANDARDS. MODIFICATIONS TO PERMANENT STORMWATER FACILITIES SHALL BE SUBJECT TO APPROVAL BY THE TOWNSHIP. MATERIALS AND DETAILS SPECIFIED SHALL NOT BE ALTERED DURING CONSTRUCTION WITHOUT WRITTEN APPROVAL BY LOWER SAUCON TOWNSHIP COUNCIL.

MAINTENANCE REQUIREMENTS

STORMWATER BASINS: INSPECTION AND MAINTENANCE OF STORMWATER BASINS SHALL OCCUR QUARTERLY, AFTER EVERY MAJOR STORM EVENT, OR MORE OFTEN IF PROBLEMS ARE PRESENT. FACILITY BERMS SHALL BE INSPECTED FOR ANY SIGNS OF EROSION AND/OR NON-VEGETATED AREAS, POTENTIAL AREAS OF WEAKNESS, ANIMAL BURROWS, AND TAMPERING. ANY AREAS OF THE BERM FOUND TO BE INADEQUATE SHALL BE REPAIRED TO ORIGINAL DESIGN SPECIFICATIONS IMMEDIATELY. FACILITY BOTTOMS SHALL BE KEPT FREE OF UNDESIRABLE VEGETATION, SEDIMENT, AND DEBRIS, AND SHALL BE KEPT IN A CLEAN CONDITION. ANY INVASIVE OR NOXIOUS PLANTS SHALL BE PURGED ENTIRELY UPON DETECTION. FACILITY INTERIORS SHALL BE KEPT FREE OF DEBRIS, INCLUDING LITTER, LEAVES, STICKS, GRASS CLIPPINGS AND SEDIMENT. IF SEDIMENT IS REMOVED FROM THE FACILITY IT SHALL BE TAKEN TO A PERMITTED SITE WITH AN APPROVED EROSION CONTROL PLAN. BASIN OUTLET STRUCTURES SHALL BE KEPT FREE OF OBSTRUCTIONS AND DEBRIS INCLUDING LITTER, LEAVES, STICKS, GRASS CLIPPINGS, DEAD OR LIVE ANIMALS AND SEDIMENT.

STORMWATER PIPING AND CULVERTS: INSPECTION AND MAINTENANCE OF STORMWATER PIPING AND CULVERTS SHALL OCCUR QUARTERLY, AFTER EVERY MAJOR STORM EVENT, OR MORE OFTEN IF PROBLEMS ARE PRESENT. STORMWATER PIPING AND CULVERTS SHALL BE KEPT FREE OF OBSTRUCTIONS AND DEBRIS INCLUDING LITTER, LEAVES, STICKS, GRASS CLIPPINGS, DEAD OR LIVE ANIMALS AND SEDIMENT. ANY RIPRAP APPLIES AT PIPE OUTLETS SHALL BE INSPECTED TO ENSURE THAT PROPER EROSION PROTECTION IS IN PLACE. ANY EROSION MUST BE REPAIRED AND WASHED-OUT RIPRAP MUST BE REPLACED TO ORIGINAL DESIGN SPECIFICATIONS. SHOULD RIPRAP WASHOUT OR EROSION OCCUR REGULARLY, THE SITE ENGINEER SHOULD BE CONTACTED TO DETERMINE IF MORE DURABLE OUTLET PROTECTION IS NEEDED, AND TO DESIGN A MORE DURABLE OUTLET PROTECTION AS NEEDED.

STORMWATER INLETS: INSPECTION AND MAINTENANCE OF STORMWATER INLETS SHALL OCCUR QUARTERLY, AFTER EVERY MAJOR STORM EVENT, OR MORE OFTEN IF PROBLEMS ARE PRESENT. STORMWATER INLETS SHALL BE KEPT FREE OF OBSTRUCTIONS AND DEBRIS INCLUDING LITTER, LEAVES, STICKS, GRASS CLIPPINGS, DEAD OR LIVE ANIMALS AND SEDIMENT.

GRASS-LINED CHANNELS AND SWALES: INSPECTION AND MAINTENANCE OF SWALES SHALL OCCUR QUARTERLY, AFTER EVERY MAJOR STORM EVENT, OR MORE OFTEN IF PROBLEMS ARE PRESENT. CHANNELS AND SWALES SHALL BE MOWED REGULARLY AS NEEDED AND SHALL BE KEPT FREE OF OBSTRUCTIONS AND DEBRIS INCLUDING LITTER, LEAVES, STICKS, GRASS CLIPPINGS, DEAD OR LIVE ANIMALS AND SEDIMENT. CHANNELS SHALL BE MAINTAINED TO THE DESIGN CAPACITY AND DIMENSIONS INDICATED ON THESE PLANS.

PERMANENTLY SEEDED AREAS (NON STORMWATER): INSPECTION AND MAINTENANCE OF PERMANENTLY SEEDED AREAS SHALL OCCUR SEMI-ANNUALLY, AFTER EVERY MAJOR STORM EVENT, OR MORE OFTEN IF PROBLEMS ARE PRESENT. AREAS WITH PERMANENT SEEDING MEASURES SHALL BE INSPECTED FOR SIGNS OF EROSION AND/OR AREAS WHERE VEGETATION HAS FAILED AS WELL AS ANY INVASIVE OR NOXIOUS PLANTS. ALL BARE SPOTS SHALL BE RE-SEEDED AND INVASIVE OR NOXIOUS PLANTS SHALL BE PURGED ENTIRELY.

ROCK LINED CHANNELS AND SWALES: INSPECTION AND MAINTENANCE OF ROCK LINED SWALES SHALL OCCUR QUARTERLY, AFTER EVERY MAJOR STORM EVENT, OR MORE OFTEN IF PROBLEMS ARE PRESENT. CHANNELS AND SWALES SHALL BE INSPECTED FOR ROCK STABILITY, SEDIMENT ACCUMULATION AND SCOUR HOLES THROUGHOUT THE LENGTH OF THE CHANNEL. REPAIR CHANNELS BY REPLACING ANY DISPLACED STONES AND REMOVE DEBRIS INCLUDING SEDIMENT. REPAIR ERODED AREAS WITH ROCK RIPRAP AS NEEDED.

DEFINITIONS

MAJOR STORM EVENT: A MAJOR STORM EVENT OR SIGNIFICANT STORM EVENT SHALL BE DEFINED AS A RAINFALL EVENT GREATER THAN 2-INCHES IN MAGNITUDE.

LEHIGH VALLEY PLANNING COMMISSION REVIEW

Reviewed by the Leigh Valley Planning Commission

DATE PLANNER

TOWNSHIP PLANNING COMMISSION RECOMENDATIONS

Recommended for approval by the Lower Saucon Township Planning Commission this

_____day of _____20____.

CHAIRMAN SECRETARY

TOWNSHIP COUNCIL APPROVAL
AND TOWNSHIP ENGINEER REVIEW

Approved by the Lower Saucon Township Council this

_____day of _____20____.

SECRETARY COUNCIL PRESIDENT
Reviewed by:

TOWNSHIP ENGINEER

This _____day of _____20____.

BETHLEHEM LANDFILL COMPANY BEING THE OWNER / EQUITABLE OWNER OF THE LANDS PROPOSED FOR SUBDIVISION LAND DEVELOPMENT PROVIDED HEREIN ACKNOWLEDGE THE STORMWATER MANAGEMENT SYSTEM TO BE A PERMANENT FIXTURE THAT CAN BE ALTERED OR REMOVED ONLY AFTER APPROVAL OF A REVISED PLAN BY LOWER SAUCON TOWNSHIP.

DAVID PANUCCI
OWNER / TITLE

SEPTEMBER 11, 2023
DATE

SEPTEMBER 11, 2023

LOWER SAUCON TWP.

NORTHAMPTON COUNTY

OWNER / APPLICANT

BETHLEHEM LANDFILL COMPANY
2335 APPLEBUTTER ROAD
BETHLEHEM, PA 18015

Bethlehem Landfill Company

PREPARED BY:




martin and martin, Inc.

phone: (717) 37 South Main Street • Suite A
264-6759 Chambersburg, Pennsylvania 17201



LOCATION OF EXISTING UNDERGROUND UTILITIES ARE BASED UPON SURFACE EVIDENCE AND EXISTING DRAWINGS AND ARE NOT GUARANTEED TO BE COMPLETE OR ACCURATE BY BYERS & RUNYON SURVEYING. CONTRACTOR SHOULD CONTACT THE PA. ONE CALL SYSTEM AT (1-800-242-1776) PRIOR TO ANY EXCAVATION AS REQUIRED BY PA. ACT 38 (1991)

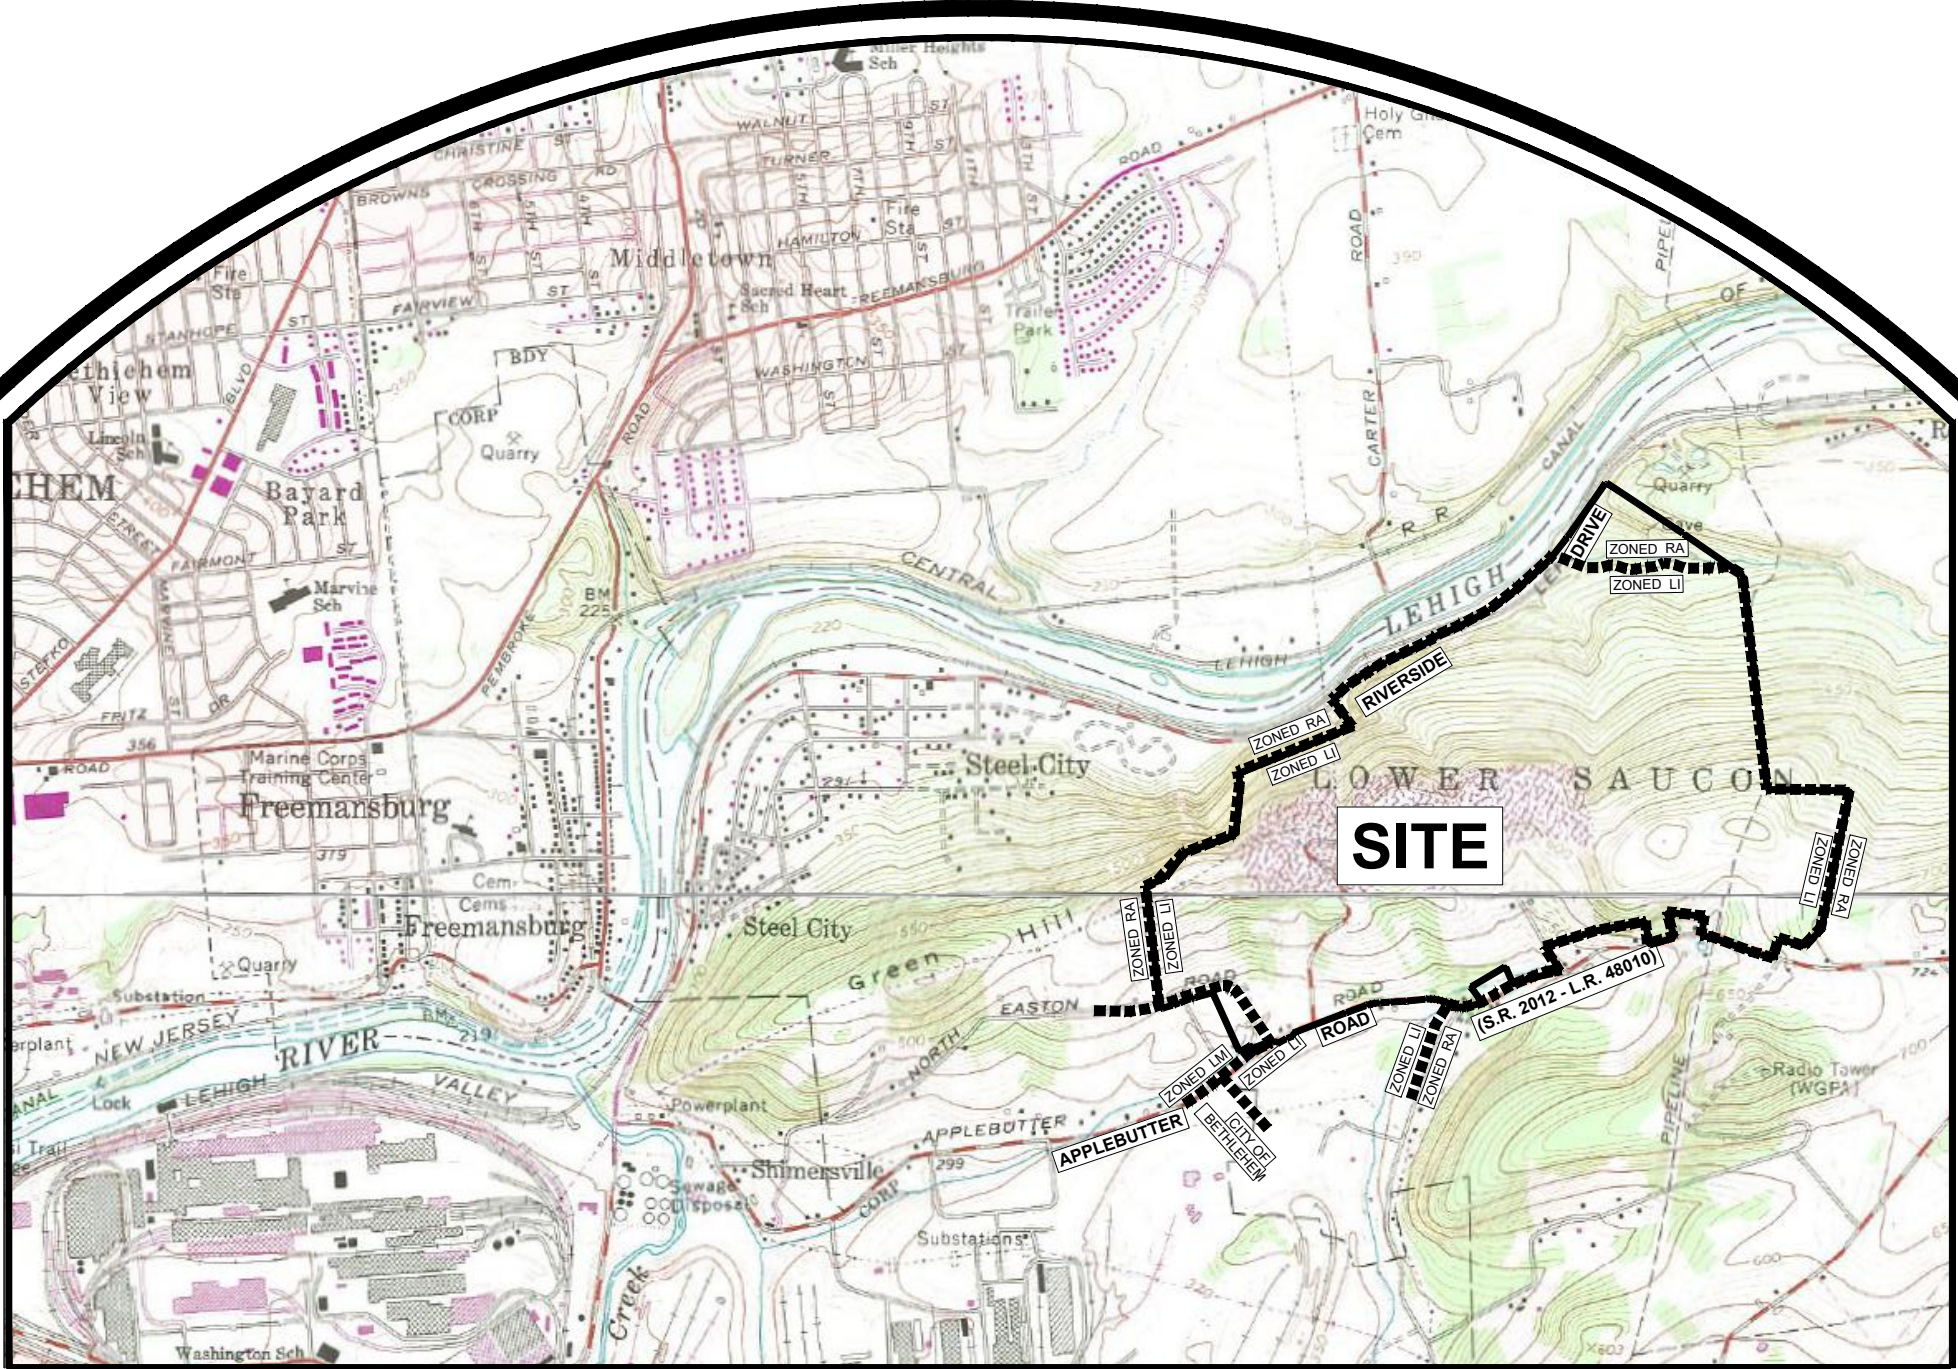

LOCATION MAP



SCALE: 1" = 2,000'

TABLE OF CONTENTS

SHEET	NAME
PC - 1	COVER SHEET
PC - 2	OVERALL POST CONSTRUCTION STORMWATER MANAGEMENT PLAN (1"=300')
PC - 3	POST CONSTRUCTION STORMWATER MANAGEMENT PLAN (1"=100')
PC - 4	POST CONSTRUCTION STORMWATER MANAGEMENT PLAN (1"=100')
PC - 5	POST CONSTRUCTION STORMWATER MANAGEMENT PLAN (1"=100')
PC - 6	POST CONSTRUCTION STORMWATER MANAGEMENT PLAN (1"=100')
PC - 7	POST CONSTRUCTION STORMWATER MANAGEMENT PLAN (1"=100')
PC - 8	STORMWATER DETENTION BASIN 7 SECTIONS AND DETAILS
PC - 9	STORMWATER DETENTION BASIN 8 SECTIONS AND DETAILS
PC - 10	CONSTRUCTION STORMWATER MANAGEMENT DETAILS
PC - 11	DETAILS
PC - 12	DETAILS
PC - 13	CULVERT PROFILES

FILE: 1162.6-PC-PV-02.07.dwg



KEY / LEGEND

- LIMIT OF DISPOSAL (DOUBLE LINER)
- CELL DIVISION
- ADJOINING PROPERTY LINE
- LANDFILL PROPERTY LINE (505,1648 ACRES PER FUTURE LOT CONSOLIDATION)
- POWER LINE R/W
- OVERHEAD UTILITY POLE
- FENCE
- EASEMENT LINE
- RIGHT OF WAY LINE
- PHASE V - AREA OF DEVELOPMENT
- PHASE V - LIMIT OF DISPOSAL
- DEP PERMIT BOUNDARY AS TAKEN FROM MARCH 1994 PERMIT DRAWINGS
- PROPOSED PADEP PERMIT BOUNDARY

GRADING LEGEND

- EXISTING CONTOURS FROM AERIAL MAPPING
- 700 - APPROVED CONTOURS WITHIN PERMITTED LIMITS OF DISPOSAL
- 725 - PROPOSED PHASE V EXPANSION CONTOURS WITHIN PROP. DISPOSAL AREA

- PROPOSED EDGE OF WOODLANDS
- EX. LANDSCAPING
- PROPOSED PHASE V STORMWATER MANAGEMENT AREA
- ACCESS ROAD - EX. ACCESS ROAD
- ACCESS ROAD - ACCESS ROAD
- MAINTENANCE ROAD - PHASE V - MAINTENANCE ROAD
- EX. BENCH SLOPE
- PROP. BENCH SLOPE
- WETLAND AREAS
- RIPARIAN CORRIDOR BUFFER
- STREAM PROTECTION EASEMENT
- WOOD LINES, TREE MASSES
- REVEGETATE / REFOREST AREA

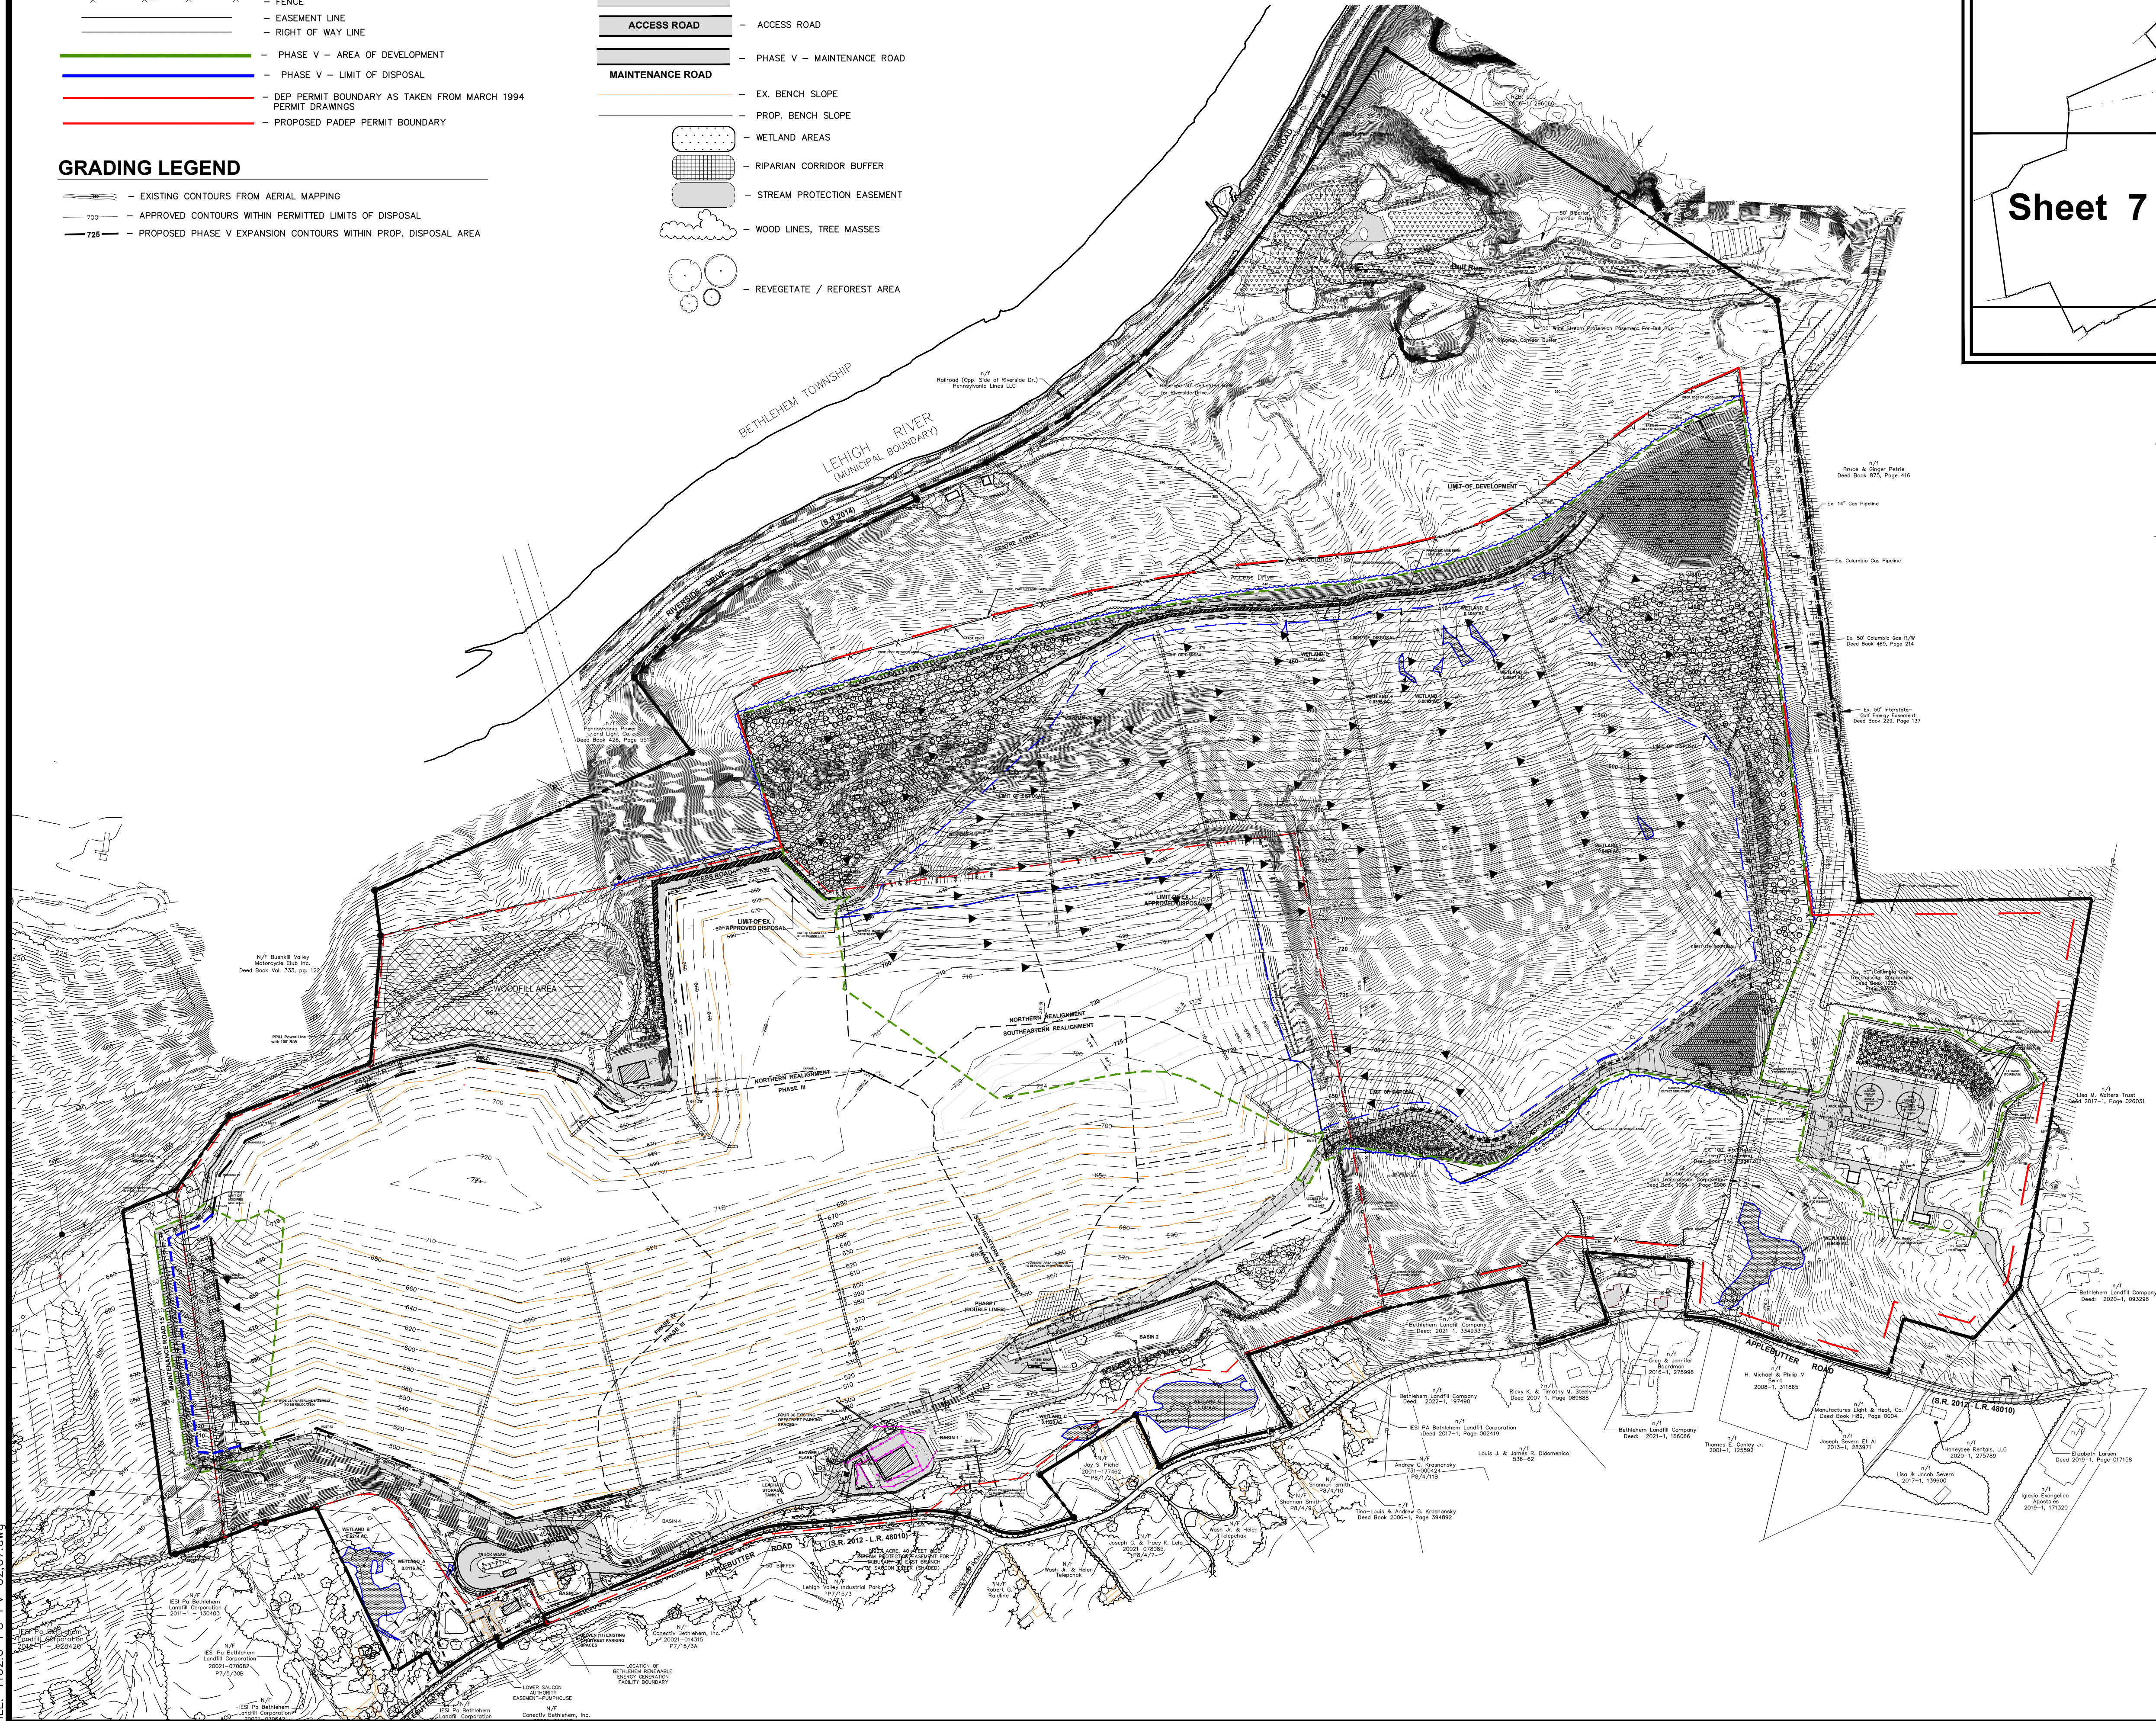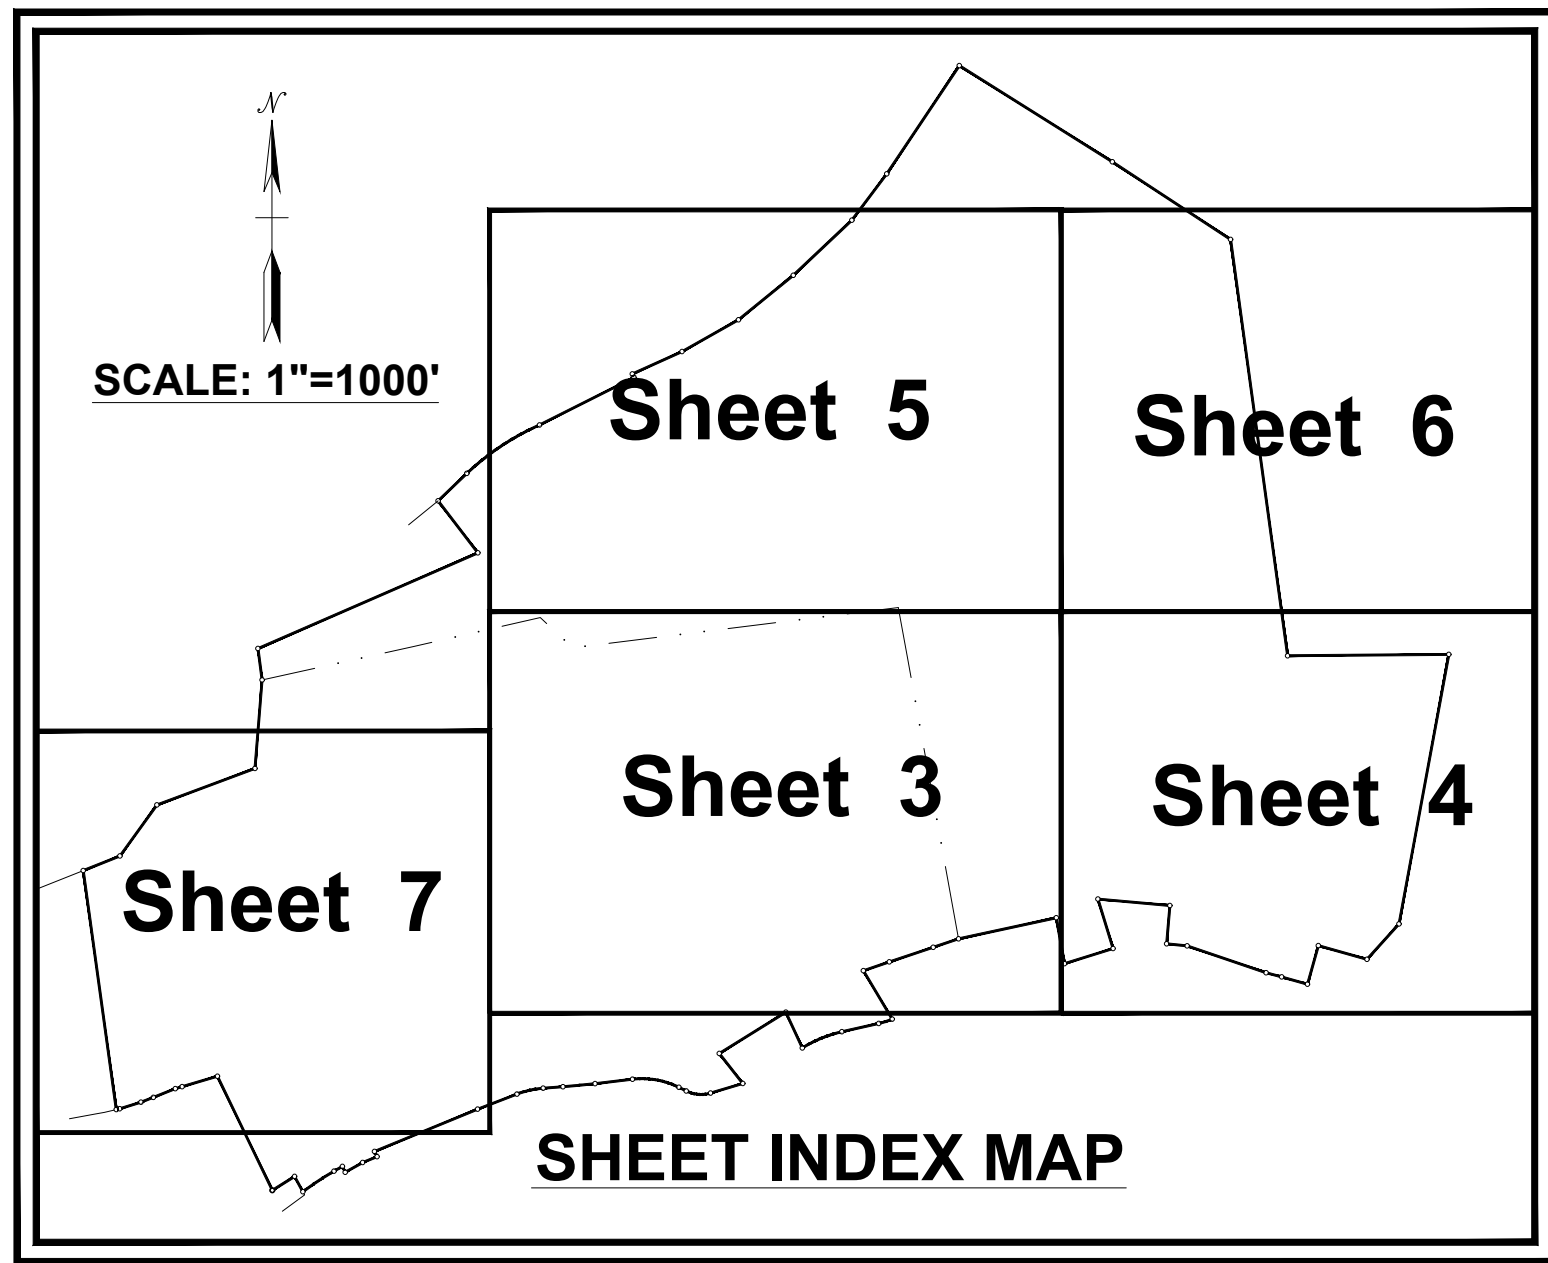

NO.	REVISION	DATE

OVERALL POST-CONSTRUCTION
STORMWATER MANAGEMENT PLAN (1"=100')

PHASE V EXPANSION

Bethlehem Landfill Company

NORTHAMPTON CO.
PENNSYLVANIA

martin and martin incorporated phone: (717) 37 south main street • suite A 264-6759 chambersburg, pennsylvania • 17201	SCALE: 1"=300'
PROJ. NO. 1162.6	DWN. BY: MSJ/DB
DSN. BY: JLM	CHK. BY: RMB


CADD FILE:
1162.6-PC-PV-02.07.dwg



DATE: 09/11/23

SCALE: 1" = 300'

DRAWING NO.

PC - 2

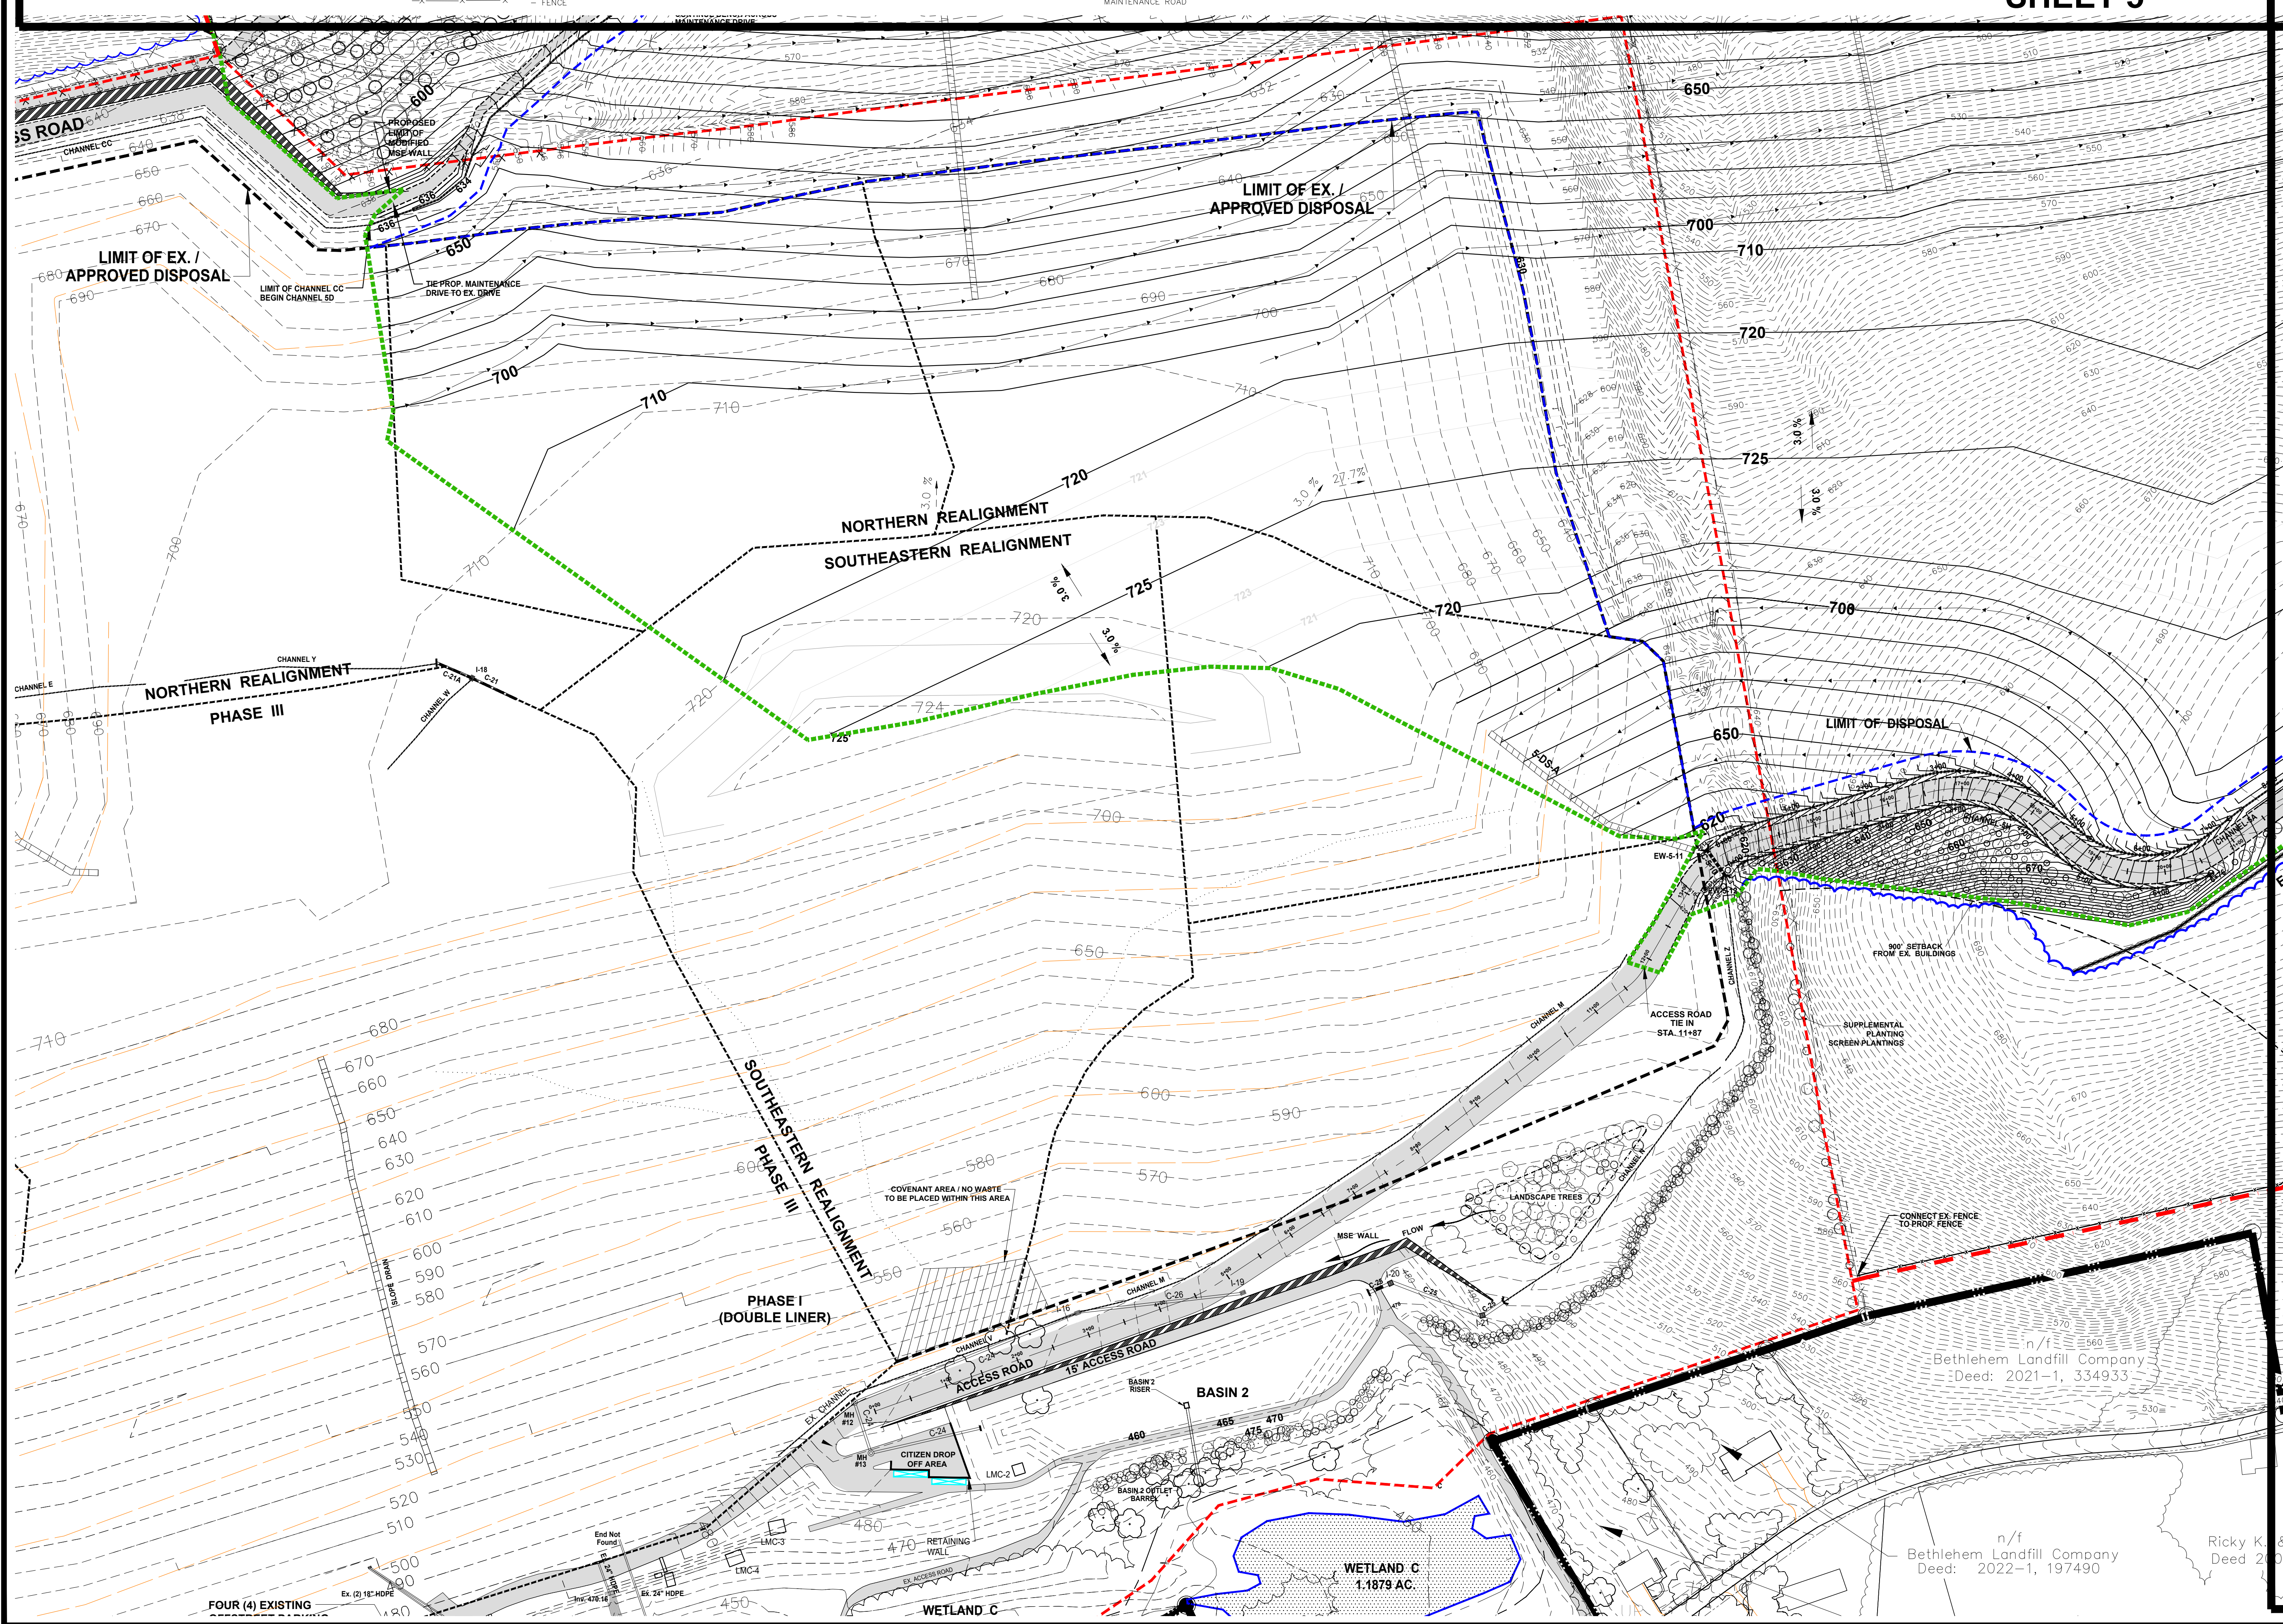

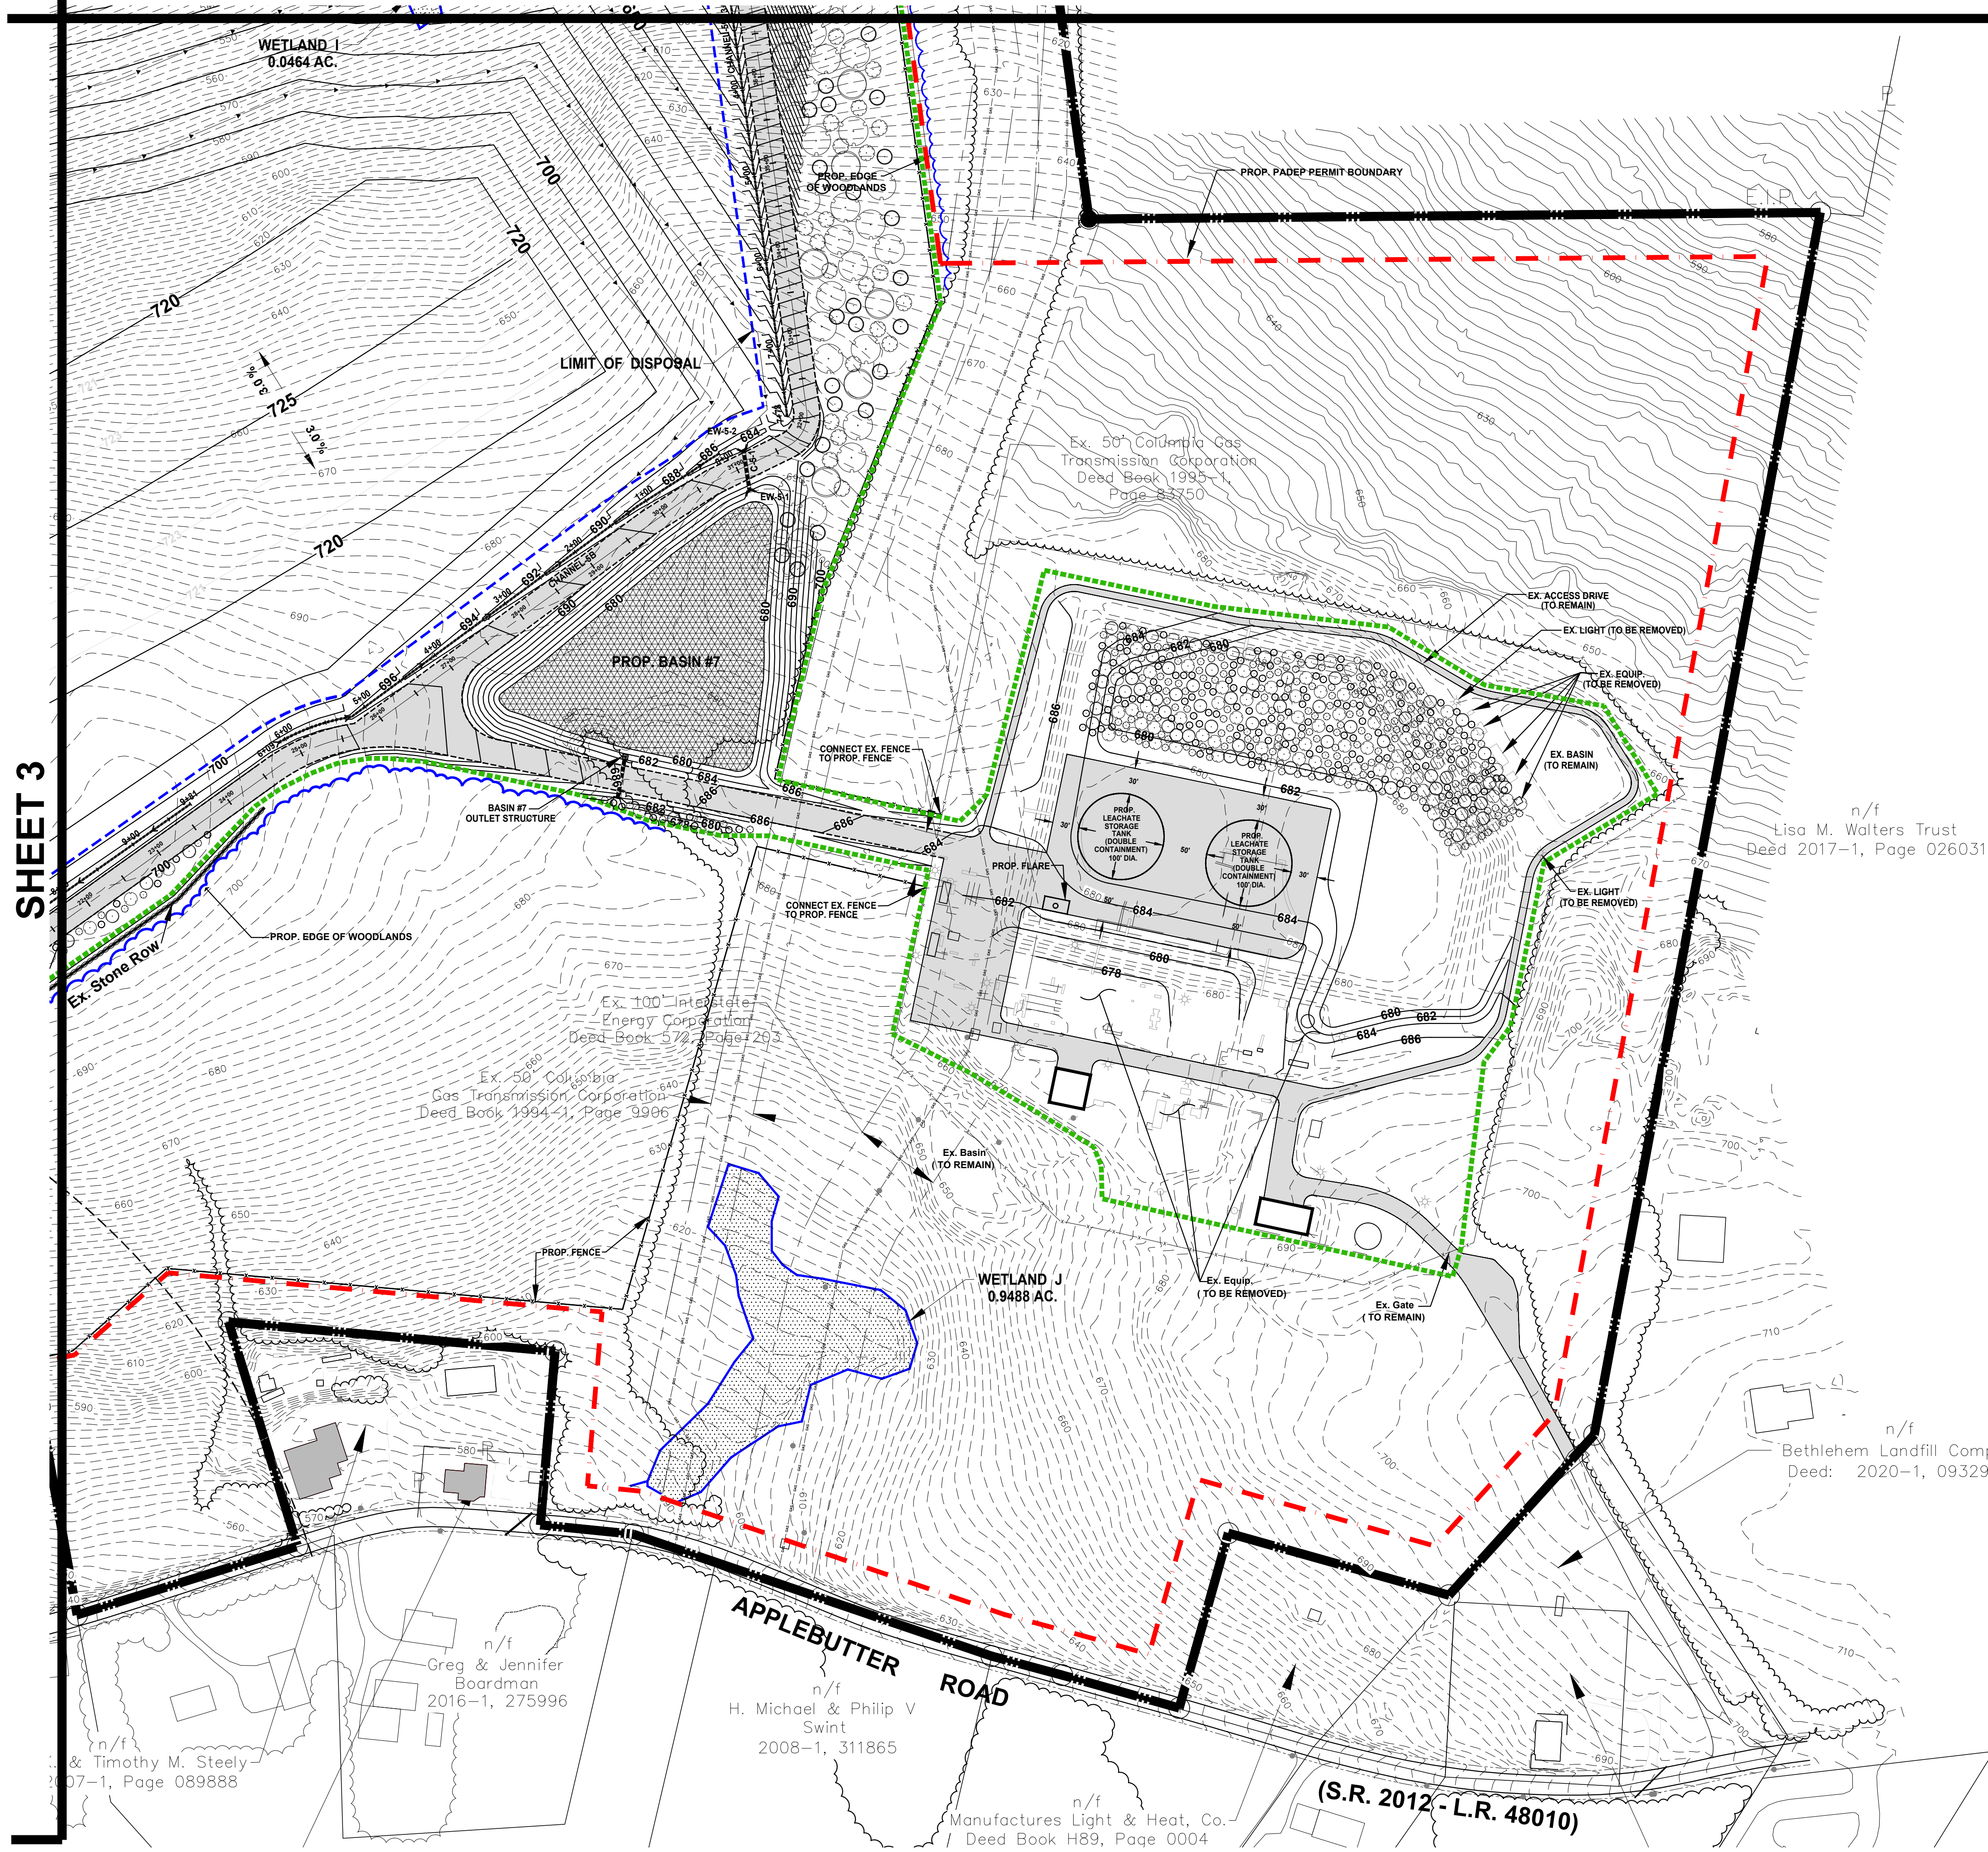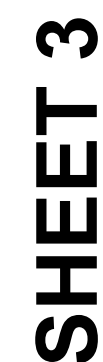
[illegible]

POST-CONSTRUCTION STORMWATER MANAGEMENT PLAN (1"=100')

NORTHAMPTON CO.

PHASE V EXPANSION
Bethlehem Landfill Company

DENNIS V. VANIA

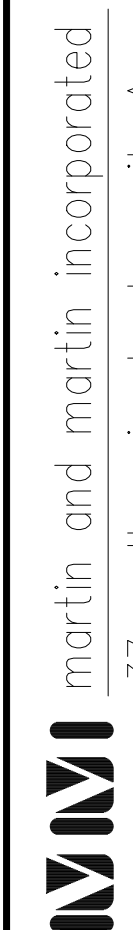

phone: (717)
264-6759

PROJ. NO.	1152.6	DWN. BY:	DB
DSN. BY:	JM	CHK. BY:	RMB

SCALE: 100' 50' 0 100' 200'

CADD FILE:
1162.6-PC-PV-02.07.dwg

DATE: 09/11/23

SCALE: 1" = 100'


DRAWING NO.

PC - 4

KEY / LEGEND

- LIMIT OF ORIGINAL LANDFILL PHASE I AND PHASE II DISPOSAL AREAS
- LIMIT OF DISPOSAL PHASE III (DOUBLE LINER)
- LIMIT OF DISPOSAL PHASE IV (DOUBLE LINER)
- CELL DIVISION
- ADJOINING PROPERTY LINE

- DEP PERMIT BOUNDARY AS TAKEN FROM MARCH 1994 PERMIT DRAWINGS
- P&M POWER LINE
- EASEMENT LINE
- RIGHT OF WAY LINE
- BUILDING RESTRICTION LINE (B.R.L.)
- EX. OR PREVIOUSLY APPROVED CONTOURS
- LANDFILL PROPERTY LINE (423.328 ACRE CONSOLIDATED DEED)

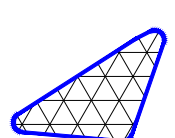

PROPOSED PHASE V STORMWATER MANAGEMENT AREA

- WETLAND AREAS
- RIPARIAN CORRIDOR BUFFER
- STREAM PROTECTION EASEMENT
- PROPOSED CONTOURS
- OVERHEAD UTILITY POLE
- FENCE

- LANDFILL WOODLAND EASEMENT
- WOODFILL AREA
- NORTHERN REALIGNMENT AREA OF DEVELOPMENT
- NORTHERN REALIGNMENT - CELL DIVISION

- NORTHERN REALIGNMENT - LIMIT OF DISPOSAL
- CHANNEL Q (EXISTING OR PREVIOUSLY APPROVED)
- CHANNEL Q (PROPOSED)
- CULVERT (EXISTING OR PREVIOUSLY APPROVED)
- CULVERT (PROPOSED)
- WOOD LINES, TREE MASSES

- INLET (EXISTING OR PREVIOUSLY APPROVED)
- INLET (PROPOSED)
- MANHOLE (EXISTING OR PREVIOUSLY APPROVED)
- MANHOLE (PROPOSED)
- NORTHERN REALIGNMENT - MSE BERM
- ACCESS ROAD
- MAINTENANCE ROAD

- BENCH (PROPOSED)
- SLOPE DRAIN (EXISTING OR PREVIOUSLY APPROVED)
- SLOPE DRAIN (PROPOSED)
- PROPOSED EDGE OF WOODLANDS
- REVEGETATE / REFOREST AREA



NO.	REVISION	DATE

POST-CONSTRUCTION STORMWATER MANAGEMENT PLAN (1"=100')	NORTHAMPTON CO.
PHASE V EXPANSION	Bethlehem Landfill Company
LOWER SAUCON TWP.	PENNSYLVANIA

MMI martin and martin incorporated
phone: (717) 37 south main street • suite A
284-6759 chambersburg, pennsylvania • 17201


PROJ. NO.	DRAWN BY	CHECKED BY
1162.6	DB	RMB
ESAL BY:	JM	

SCALE: 1" = 100'

GRAPHIC SCALE: 0 50' 100' 200'

CADD FILE:	1162.6-PC-PV-02.07.dwg
DATE:	09/11/23
SCALE:	1" = 100'
DRAWING NO.	PC - 5

SHEET 6

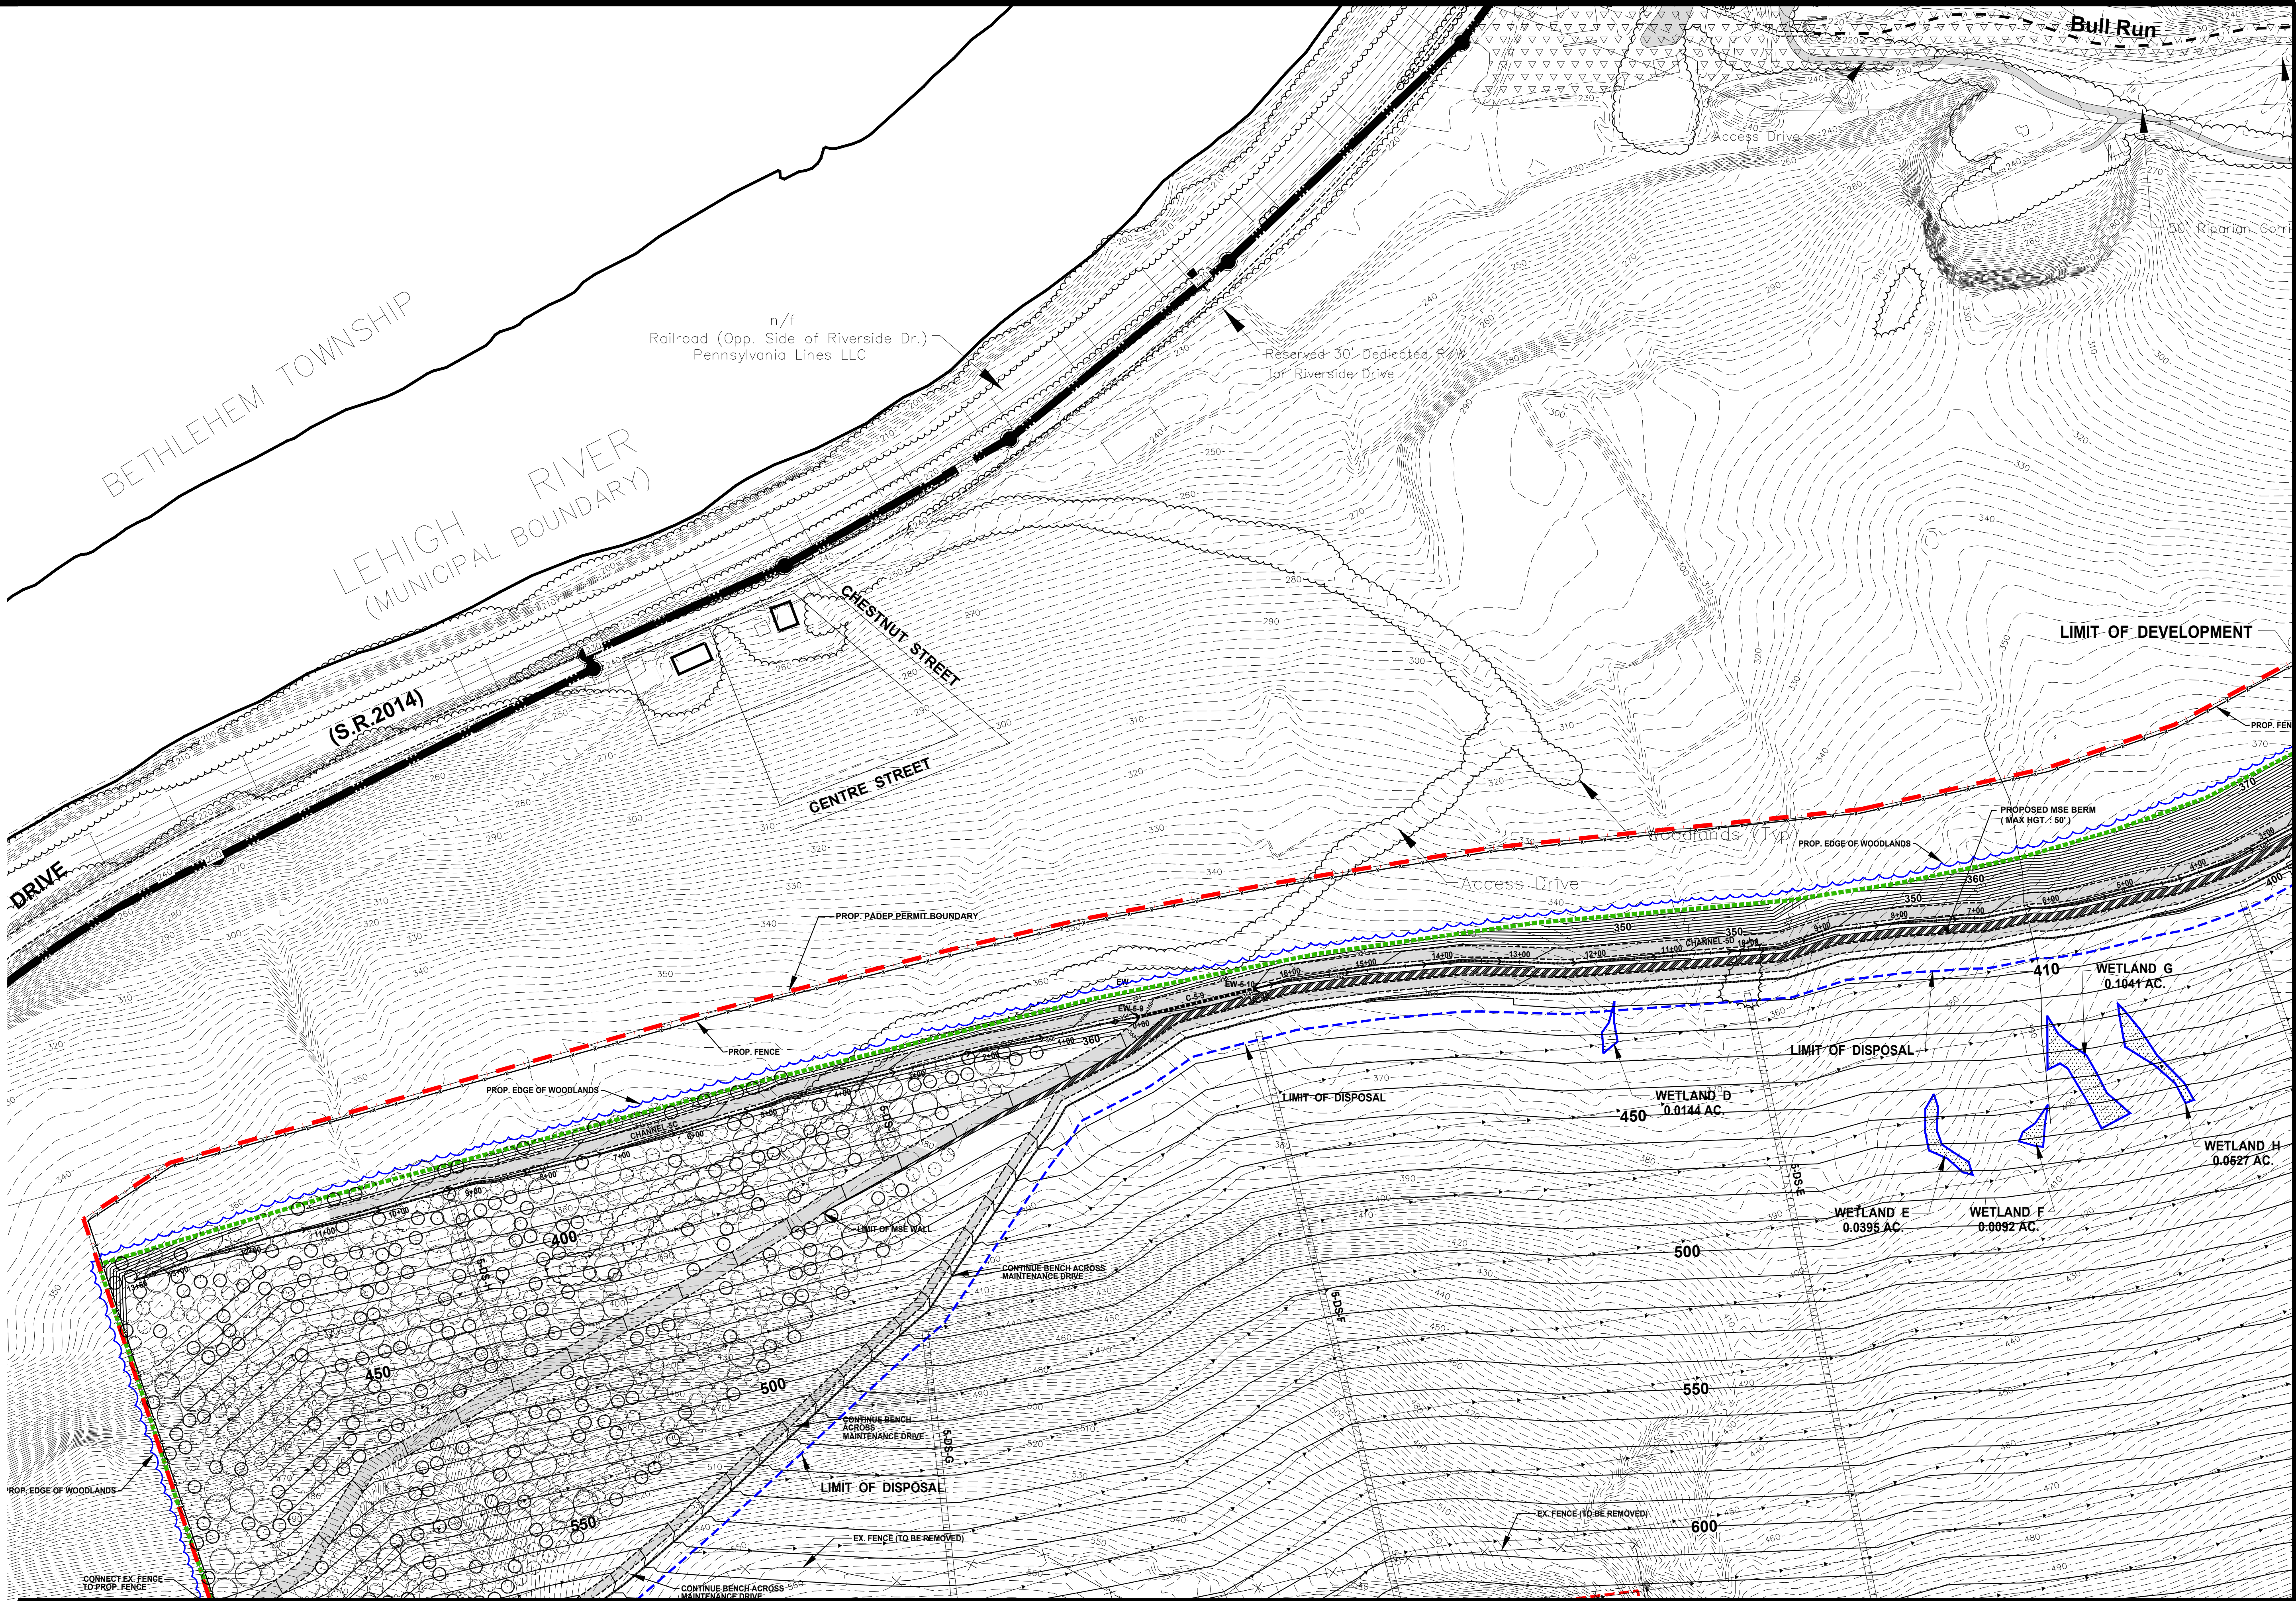

SHEET 3


[illegible]

POST-CONSTRUCTION STORMWATER MANAGEMENT PLAN (1"=100')

NORTHAMPTON CO.

PHASE V EXPANSION
Bethlehem Landfill Company

PENNSYLVANIA

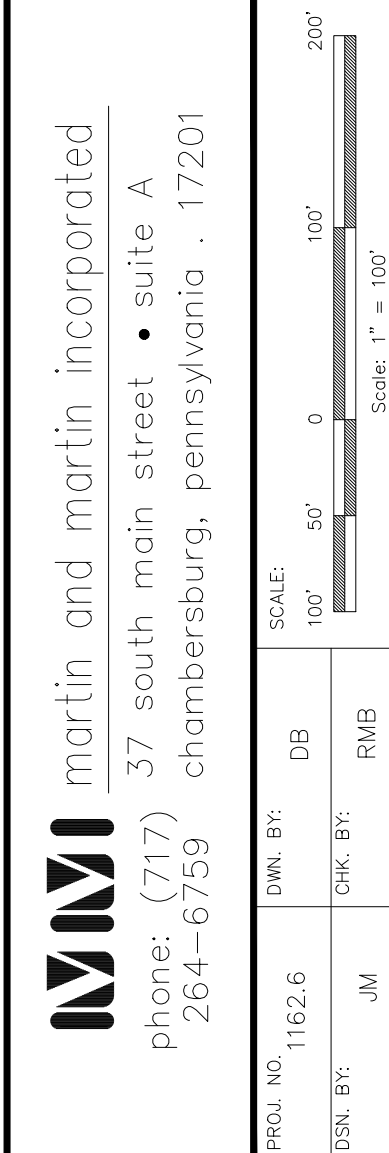

CADD FILE:
1162.6-PC-PV-02,07.dwg

DATE: 09/11/23

SCALE: 1" = 100'

DRAWING NO.

PC - 6

SHEET4

— LIMIT OF ORIGINAL LANDFILL,
PHASE I AND PHASE II DISPOSAL AREAS

=====

— LIMIT OF DISPOSAL PHASE III (DOUBLE LINER)

=====

— LIMIT OF DISPOSAL PHASE IV (DOUBLE LINER)

— CELL DIVISION

— ADJOINING PROPERTY LINE

- DEP PERMIT BOUNDARY AS TAKEN FROM MARCH 1994 PERMIT DRAWINGS
- PP&L POWER LINE
- EASEMENT LINE
- RIGHT OF WAY LINE
- BUILDING RESTRICTION LINE (B.R.L.)
- EX. OR PREVIOUSLY APPROVED CONTOURS
- LANDFILL PROPERTY LINE
(423.328 ACRE CONSOLIDATED DEED)



PROPOSED PHASE
STORMWATER
MANAGEMENT AREA



-  - WETLAND AREAS
-  - RIPARIAN CORRIDOR BUFFER
-  - STREAM PROTECTION EASEMENT
- 630 - PROPOSED CONTOURS
- - OVERHEAD UTILITY POLE
-  - FENCE



-  - LANDFILL WOODLAND EASEMENT
-  - WOODFILL AREA
- - NORTHERN REALIGNMENT AREA OF DEVELOPMENT
-  - NORTHERN REALIGNMENT -

- NORTHERN REALIGNMENT-
- CHANNEL $\mathcal{Q}$ (EXISTING OR PROPOSED)
- CHANNEL $\mathcal{Q}$ (PROPOSED)
- CULVERT (EXISTING OR PROPOSED)
- CULVERT (PROPOSED)


DIVISION

WOOD LINES, TREE MASSES

- NORTHERN REALIGNMENT- LIMIT OF DISPOSAL
- CHANNEL $\frac{1}{2}$ (EXISTING OR PREVIOUSLY APPROVED)
- CHANNEL $\frac{1}{2}$ (PROPOSED)
- CULVERT (EXISTING OR PREVIOUSLY APPROVED)
- CULVERT (PROPOSED)

☐ - INLET (EXISTING OR PREVIOUSLY APPROVED)
☒ - INLET (PROPOSED)
☐ - MANHOLE (EXISTING OR PREVIOUSLY APPROVED)
 - NORTHERN REALIGNMENT - MOUNTAIN ROAD
 - ACCESS ROAD
 - NORTHERN REALIGNMENT
 - MAINTENANCE ROAD

⊙ - MANHOLE (PROPOSED)
 ———— - BENCH (PROPOSED)
 ———— - SLOPE DRAIN (EXISTING OR PREVIOUSLY APPROVED)
 - - - - - SLOPE DRAIN (PROPOSED)
 ~~~~~~ - PROPOSED EDGE OF WOODLANDS  
 ○ ○ ○ ○ - REVEGETATE / REFOREST AREA

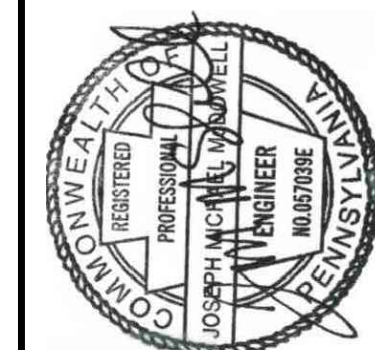

| N.O. | REVISION | DATE |
|------|----------|------|
|      |          |      |
|      |          |      |
POST-CONSTRUCTION STORMWATER MANAGEMENT PLAN (1"=100')

POWER SAUCON TWP.

PHASE V EXPANSION

Bethlehem Landfill Company

NORTHAMPTON CO.



martin and martin incorporated

37 south main street • suite A  
chambersburg, pennsylvania , 17201  
phone: (717)  
264-6759

|           |        |           |    |        |                              |
|-----------|--------|-----------|----|--------|------------------------------|
| PROJ. NO. | 1162.6 | DWA. BY:  | DB | SCALE: | 100' = 50' = 0 = 100' = 200' |
| DATE:     |        | CHEK. BY: |    |        |                              |

|             |                        |
|-------------|------------------------|
| CADD FILE:  | 1162.6-PC-PV-02.07.dwg |
| DATE:       | 09/11/23               |
| SCALE:      | 1" = 100'              |
| DRAWING NO. |                        |

PC - 7

# SHEET 3

FILE: 1162.6-PC-PV-02,07.dwg



Figure 1: Standard symbols for the proposed project. The figure is divided into two columns. The left column contains symbols for easement lines, right-of-way lines, building restriction lines, wetland areas, riparian corridor buffers, stream protection easements, proposed contours, overhead utility poles, fences, culverts, wood lines, tree masses, and channel cuts. The right column contains symbols for inlets, manholes, access roads, maintenance roads, bench marks, slope drains, proposed edges of woodlands, and revegetation/forestation areas. Each symbol is accompanied by a descriptive text label.

**Left Column Symbols:**

- EASEMENT LINE
- RIGHT OF WAY LINE
- BUILDING RESTRICTION LINE (B.R.L.)
- EX. OR PREVIOUSLY APPROVED CONTOURS
- WETLAND AREAS
- RIPARIAN CORRIDOR BUFFER
- STREAM PROTECTION EASEMENT
- PROPOSED CONTOURS
- OVERHEAD UTILITY POLE
- FENCE
- CULVERT (PROPOSED)
- WOOD LINES, TREE MASSES
- CHANNEL CUT (PROPOSED)

**Right Column Symbols:**

- INLET (EXISTING OR PREVIOUSLY APPROVED)
- INLET (PROPOSED)
- MANHOLE (EXISTING OR PREVIOUSLY APPROVED)
- ACCESS ROAD
- PHASE V REALIGNMENT ACCESS ROAD
- MAINTENANCE ROAD
- NORTHERN REALIGNMENT MAINTENANCE ROAD
- MANHOLE (PROPOSED)
- BENCH (PROPOSED)
- SLOPE DRAIN (EXISTING OR PREVIOUSLY APPROVED)
- SLOPE DRAIN (PROPOSED)
- PROPOSED EDGE OF WOODLANDS
- REVEGETATE / REFOREST AREA




IMPROVEMENTS TO BASIN 7 SHALL BE COMPLETED AT FINAL CLOSURE

 - AREA TO BE REVEGETATED WITH RETENTION BASIN FLOOR SEED MIX. \* 1.25 AC.

 - PENNDOT FORMULA D SEED MIX. 0.86 AC.

\* RETENTION BASIN FLOOR SEED MIX AS MANUFACTURED BY ERNST CONSERVATION SEEDS, CONTAINS A MIXTURE OF WET TOLLERANT NATIVE SEEDS INCLUDING BUT NOT LIMITED TO VIRGINIA WILDRYE, ALKALIGRASS, DEER TONGUE, FOX SEDGE, AND CREEPING BENTGRASS.

| Elevation-Capacity Table |                |                     |
|--------------------------|----------------|---------------------|
| Basin #7                 | Elevation      | Capacity<br>(ac-ft) |
|                          | 680            | 0.00                |
|                          | 682            | 2.70                |
|                          | 684            | 5.60                |
|                          | 686            | 8.80                |
|                          | Top Of<br>Berm |                     |

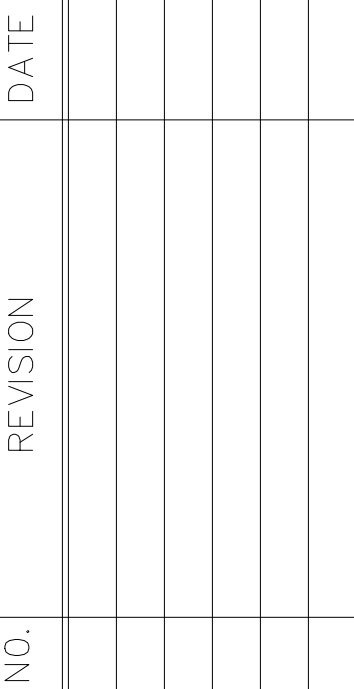

**Bethlehem Landfill Company**  
PENNSYLVANIA


[illegible]

DRAWING NO.


**PC - 8**




- EASEMENT LINE
- RIGHT OF WAY LINE
- BUILDING RESTRICTION LINE (B.R.L.)
- EX. OR PREVIOUSLY APPROVED CONTROLS
- WETLAND AREAS
- RIPARIAN CORRIDOR BUFFER
- STREAM PROTECTION EASEMENT
- PROPOSED CONTROLS
- OVERHEAD UTILITY POLE
- FENCE
- CULVERT (PROPOSED)
- WOOD LINES, TREE MASSES
- CHANNEL C (PROPOSED)
- PROPOSED LEVEL SPREADER

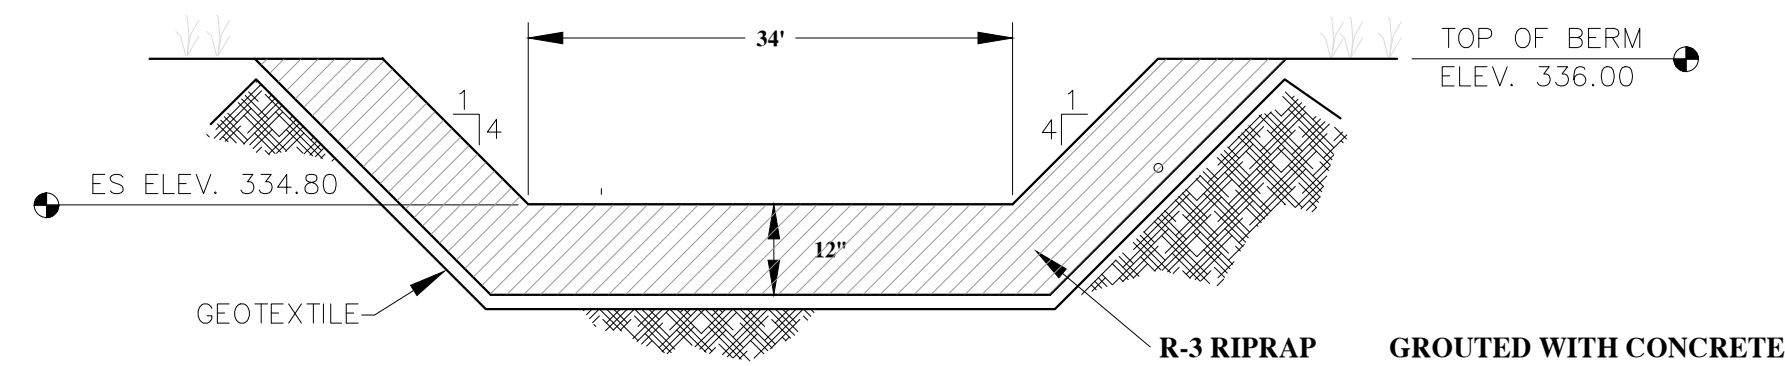


Not to Scale

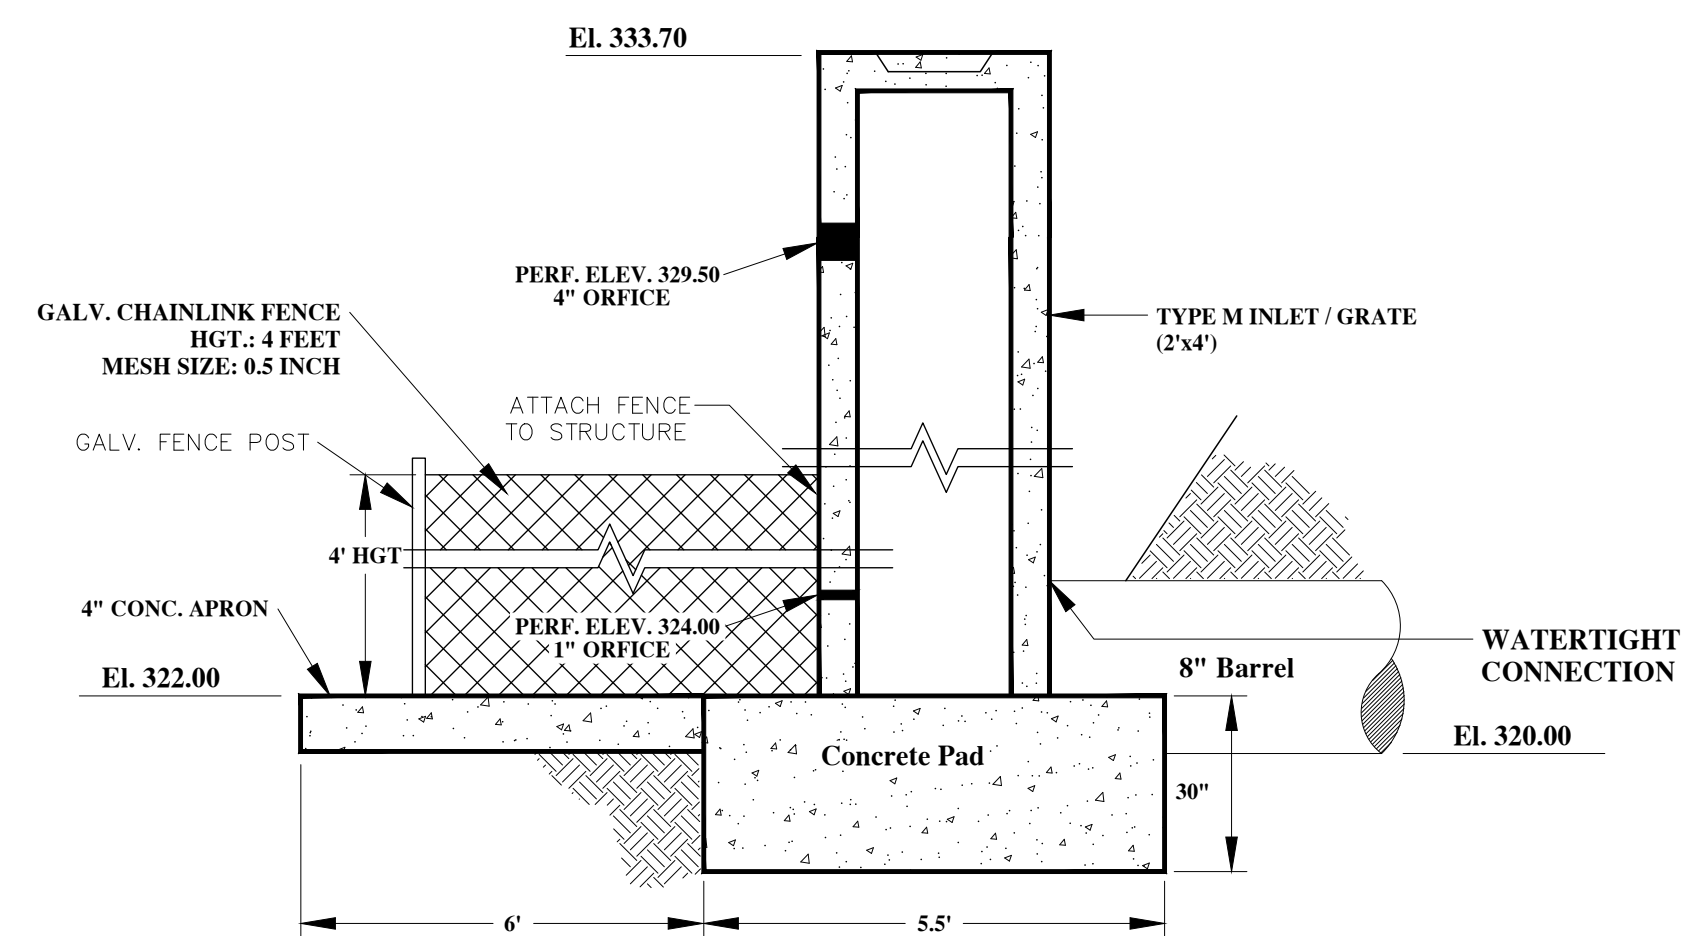


**Not to Scale**

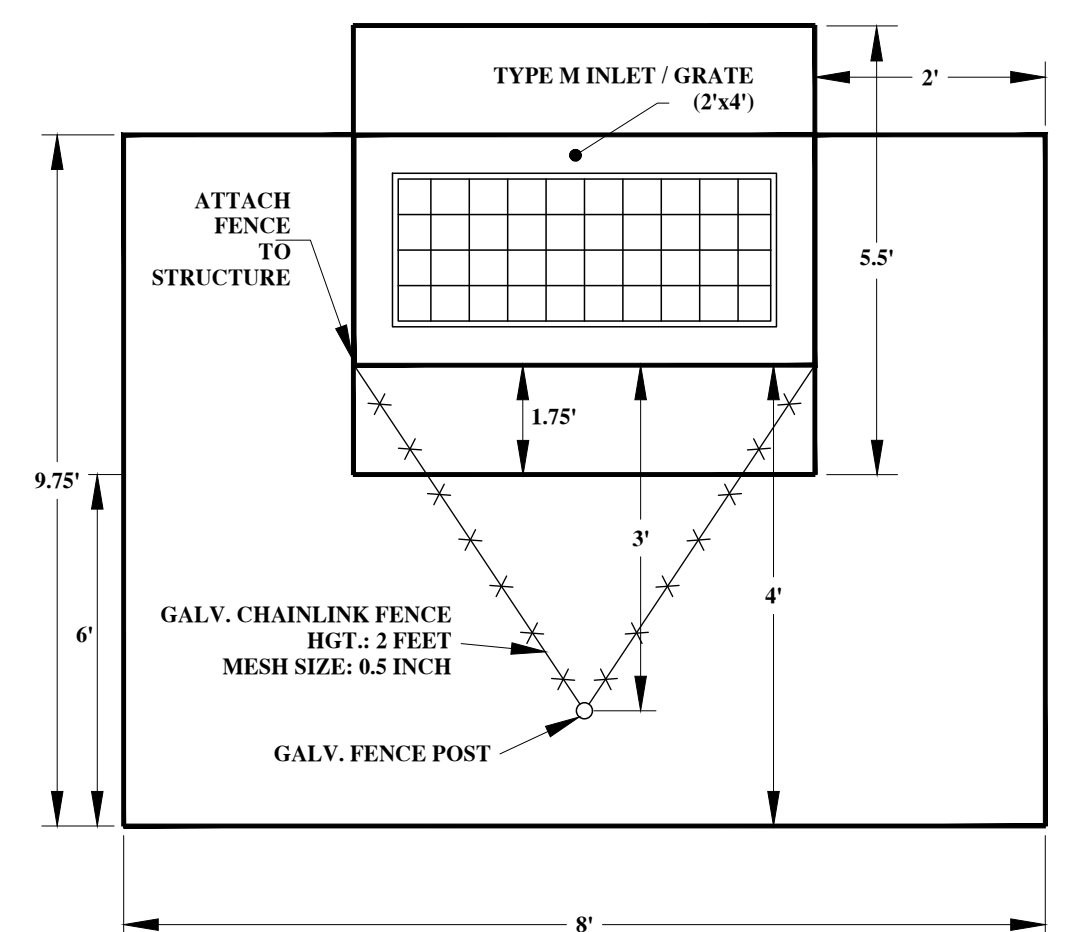

**Not to Scale**

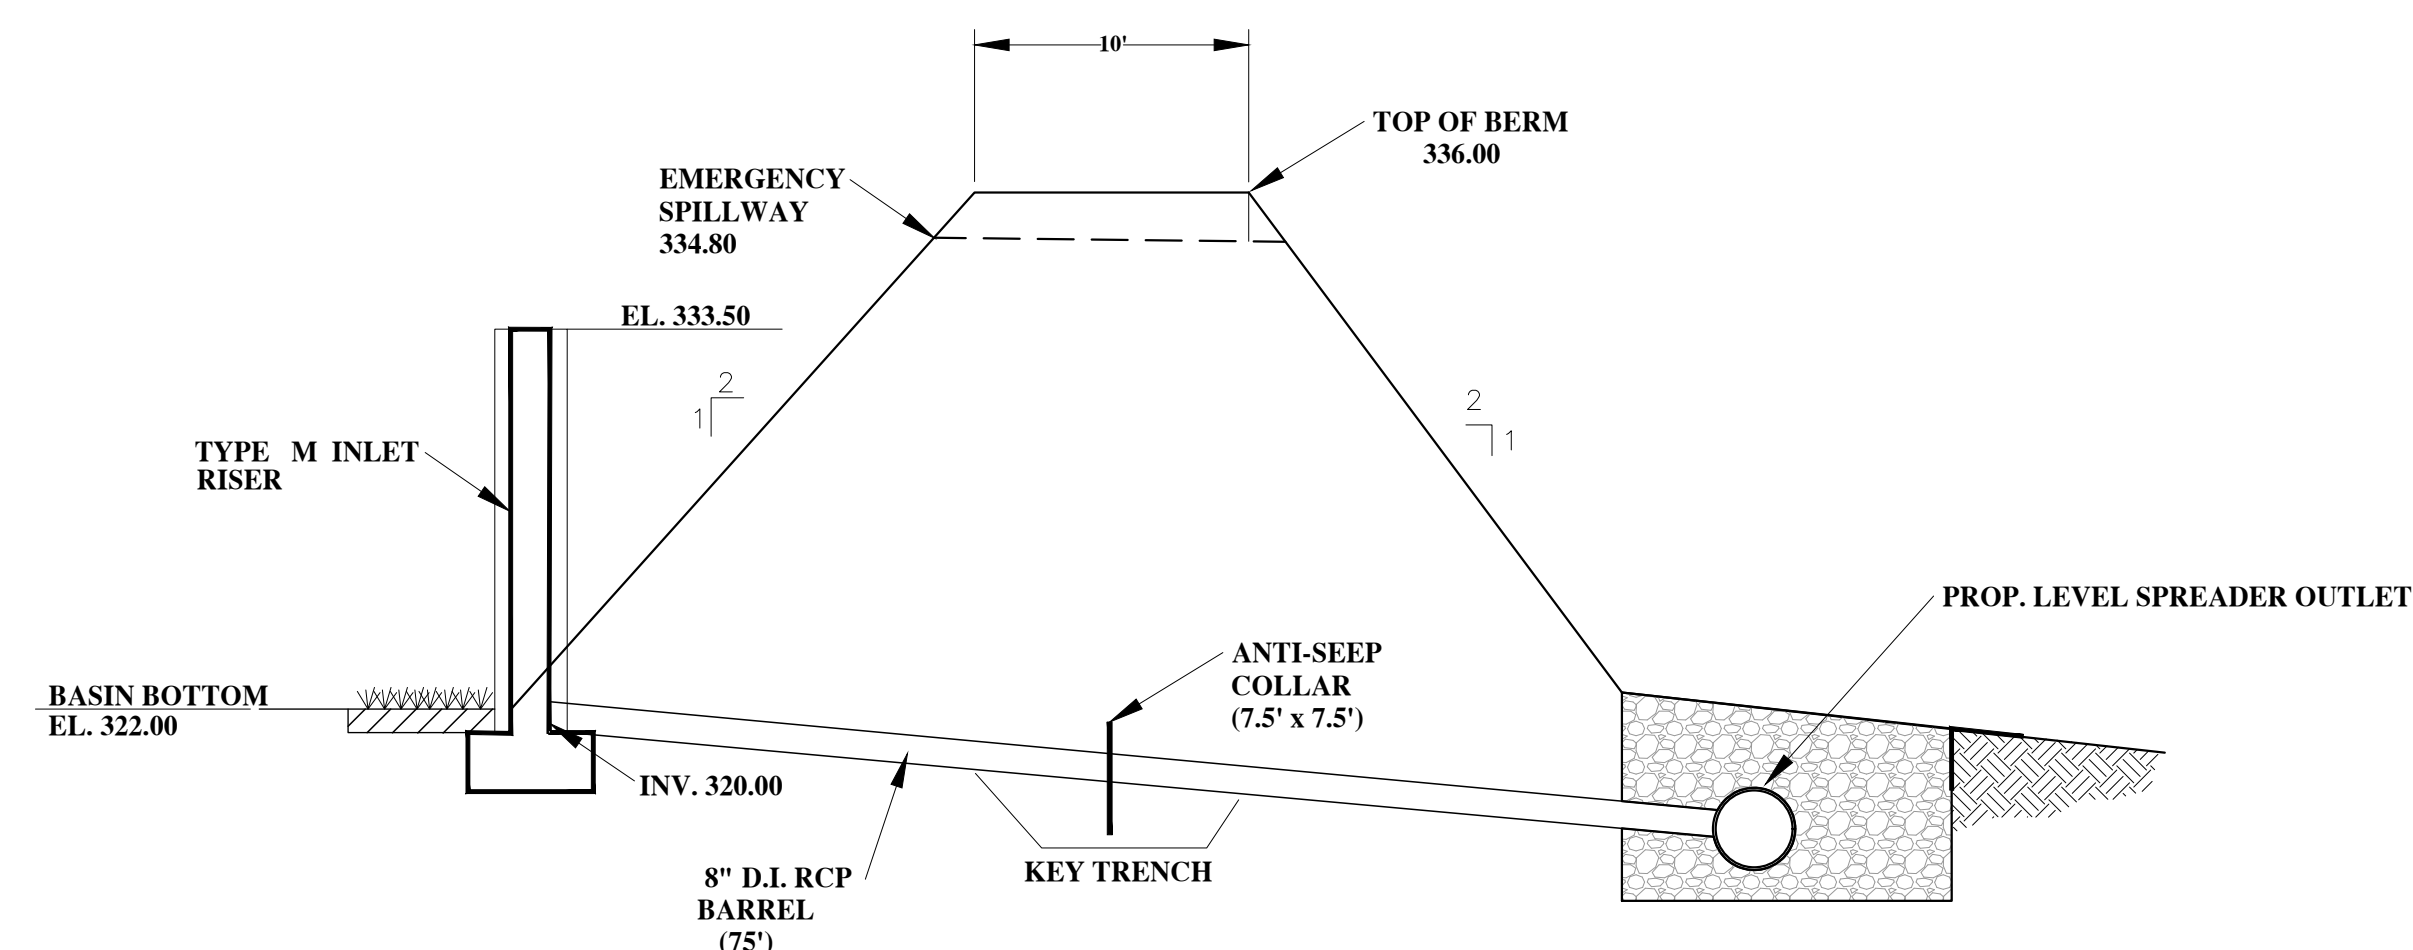

**Not to Scale**

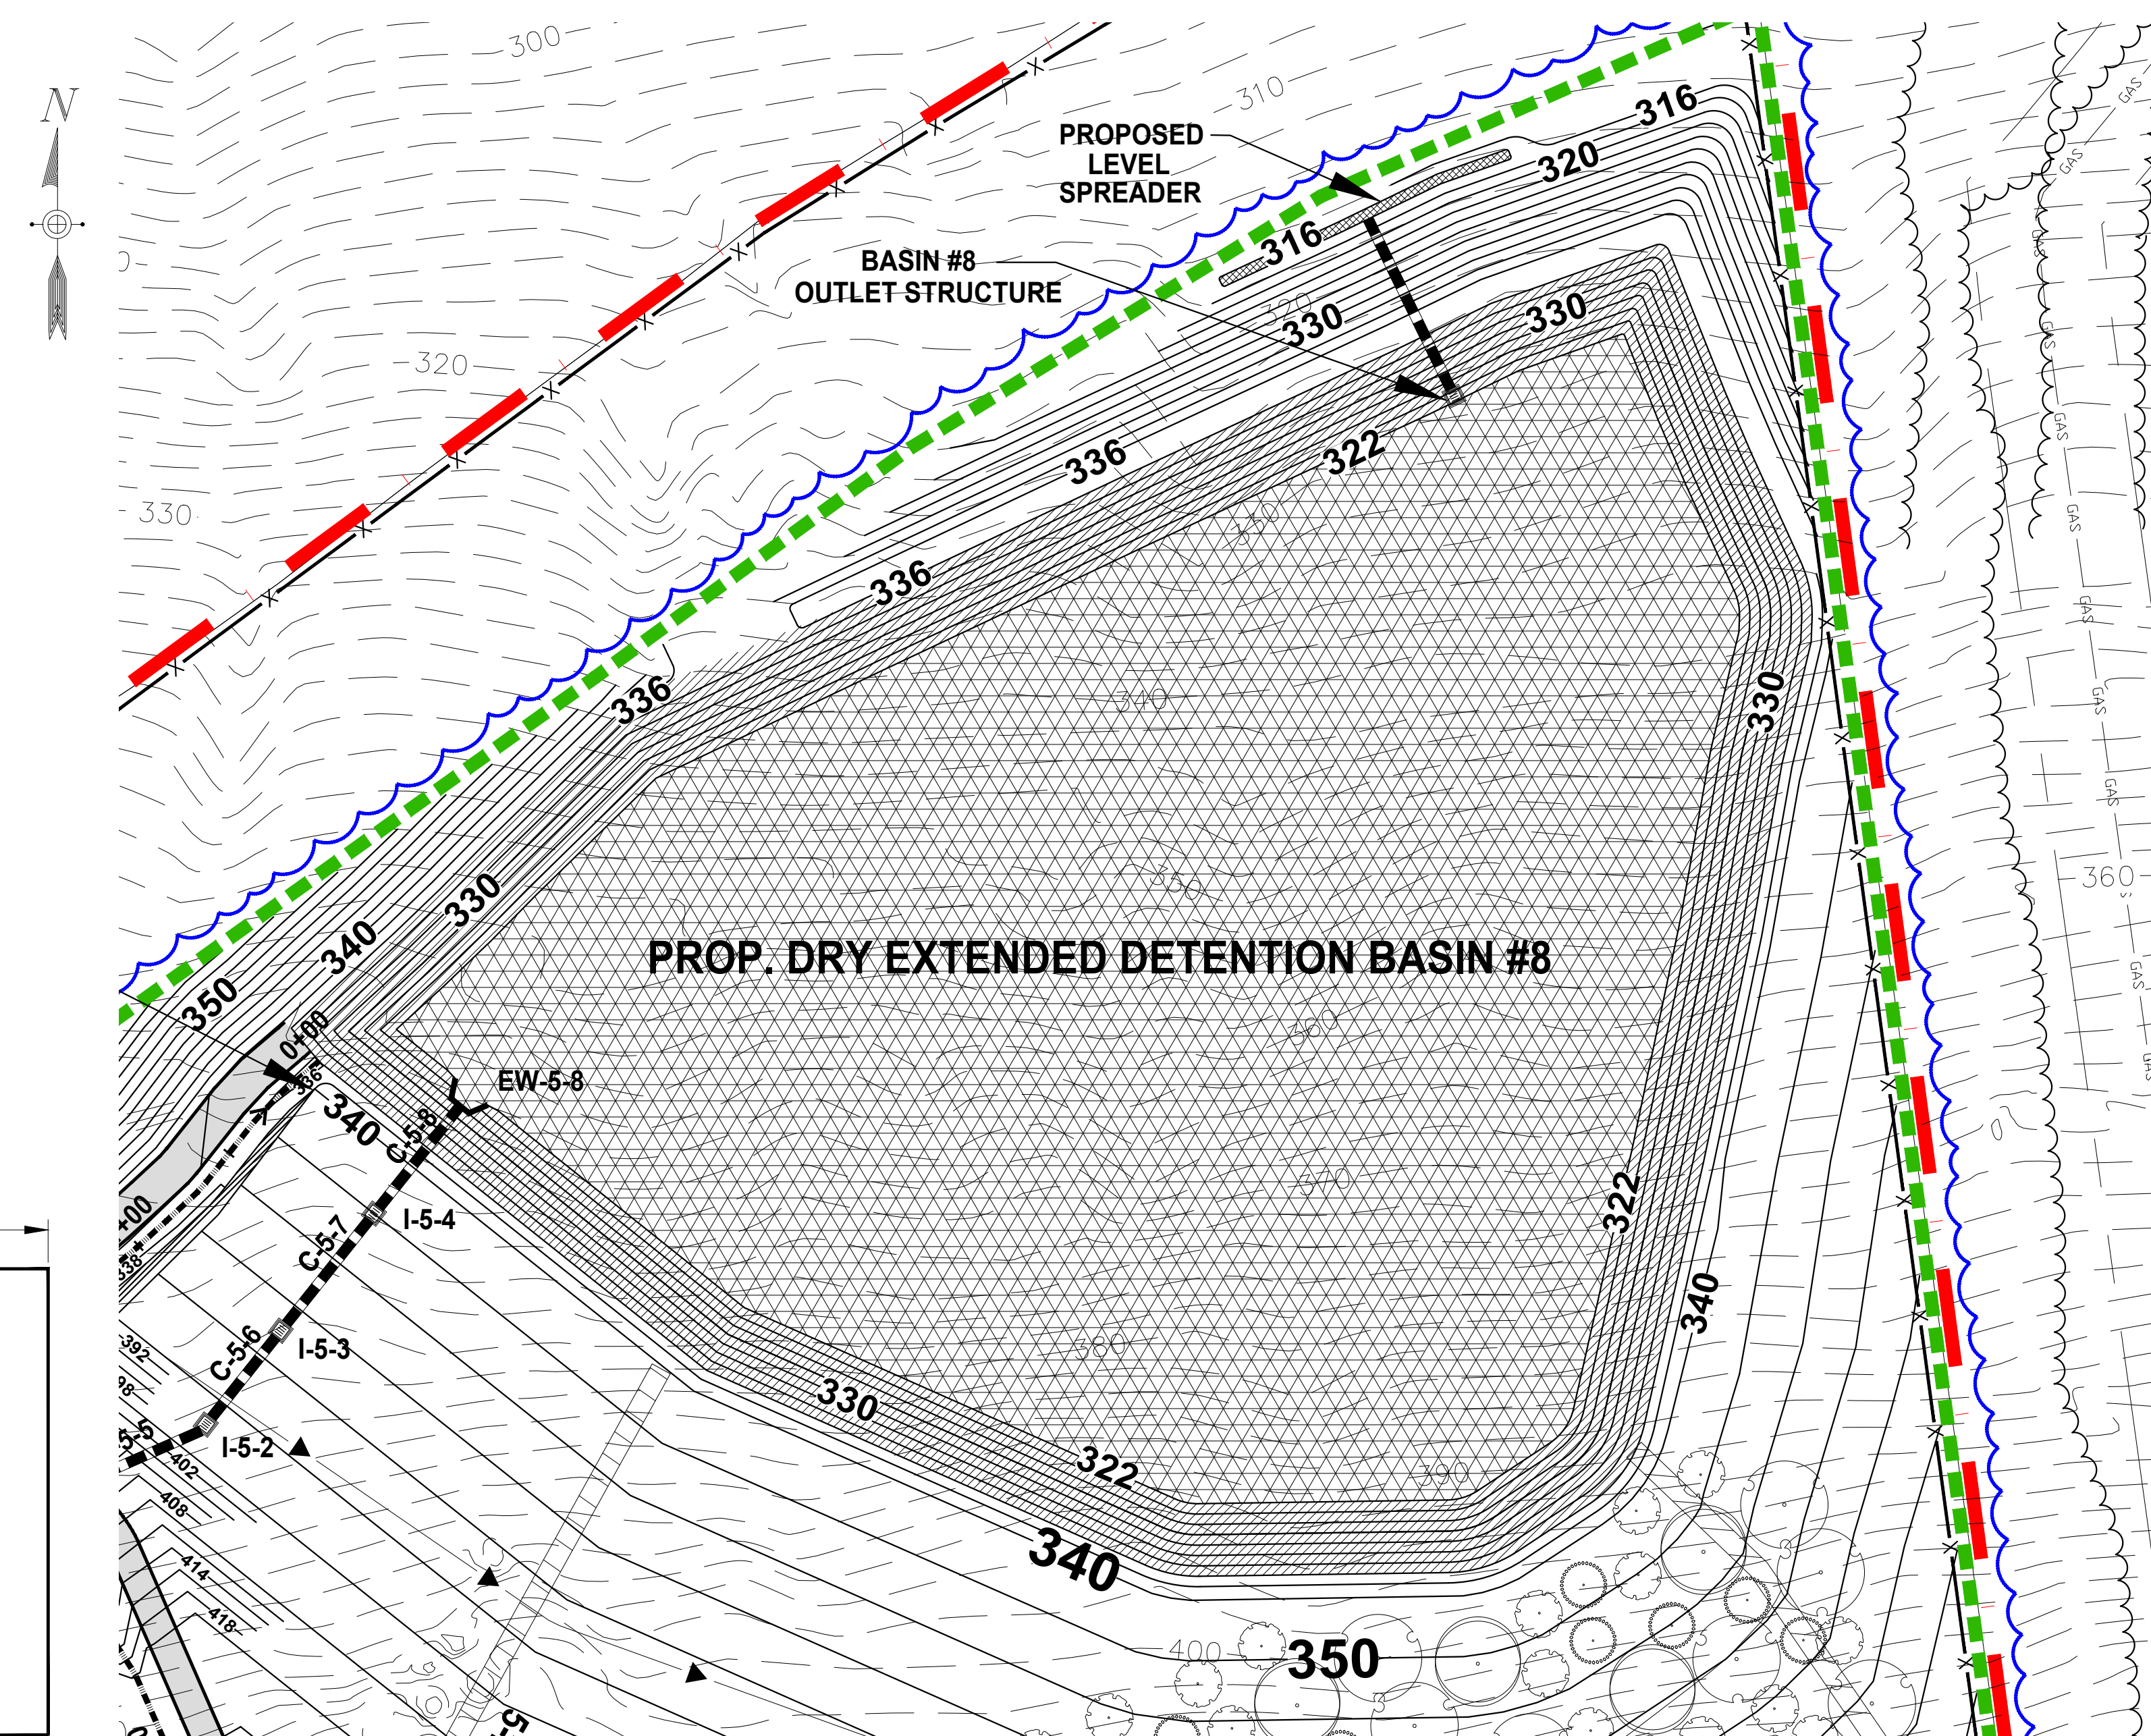

**SCALE: 1" = 50'**

IMPROVEMENTS TO BASIN 8 SHALL BE COMPLETED AT FINAL CLOSURE


-  - AREA TO BE REVEGETATED WITH RETENTION  
BASIN FLOOR SEED MIX. \* 3.26 AC.
-  - PENNDOT FORMULA D SEED MIX. 1.03 AC.

\* RETENTION BASIN FLOOR SEED MIX AS MANUFACTURED BY ERNST CONSERVATION SEEDS, CONTAINS A MIXTURE OF WET TOLLERANT NATIVE SEEDS INCLUDING BUT NOT LIMITED TO VIRGINIA WILDRYE, ALKALIGRASS, DEER TONGUE, FOX SEDGE, AND CREEPING BENTGRASS.

| Elevation-Capacity Table |           |           |                  |
|--------------------------|-----------|-----------|------------------|
| Basin #8                 | Elevation | Area (ac) | Capacity (ac-ft) |
|                          | 322       | 3.38      | 0.00             |
|                          | 324       | 3.52      | 6.90             |
|                          | 326       | 3.66      | 14.08            |
|                          | 328       | 3.81      | 21.55            |
|                          | 330       | 3.96      | 29.32            |
|                          | 332       | 4.11      | 37.39            |
|                          | 334       | 4.26      | 45.76            |
|                          | 336       | 4.42      | 54.44            |
| Top Of Berm              |           |           |                  |

**Q\_25 = 0.67**  
**0.67 CFS x 100 FT/CFS = 67 FT(MIN)**  
**PRO. LENGTH = 125 FT**

**Figure G.5. Typical Orientation of Level Spreader with Subsurface Discharge**

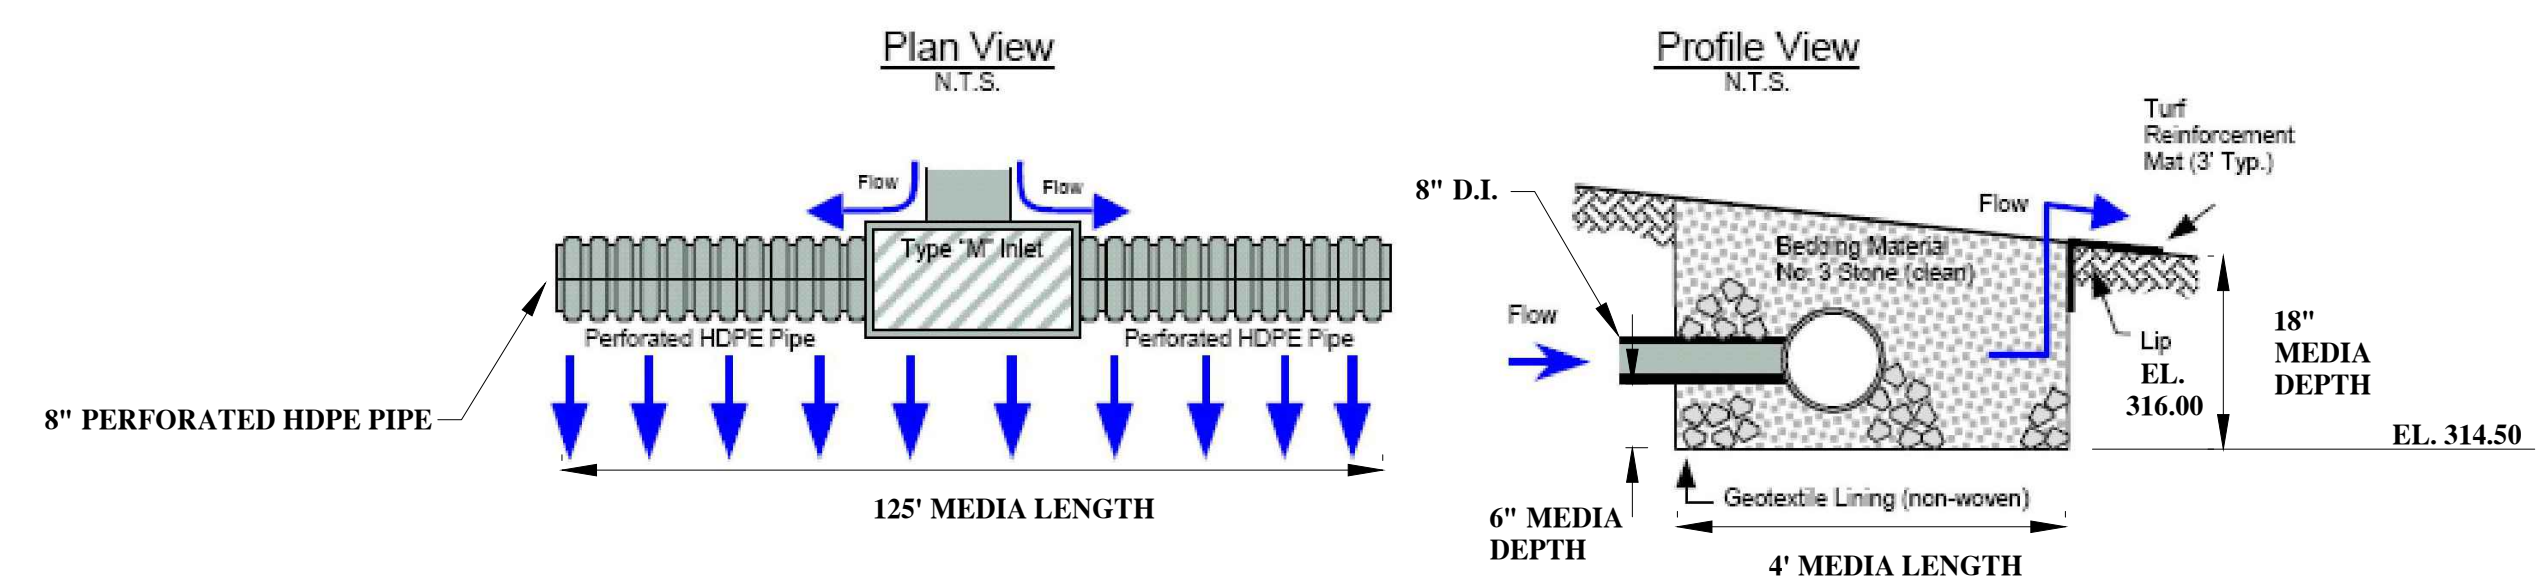

**Not to Scale**

[illegible]

## STORMWATER DETENTION BASIN #8 SECTIONS AND DETAILS

PHASE V EXPANSION  
**Bethlehem Landfill Company**  
PENNSYLVANIA  
LOWER SAUCON TWP.  
NORTHAMPTON CO.

**MMI** martin and martin incorporated  
phone: (717) 37 south main street suite A •  
264-6759 chambersburg, pennsylvania • 17201

|           |        |          |        |
|-----------|--------|----------|--------|
| PROJ. NO. | 1162.6 | DWN. BY: | MSH/DB |
| OSN. BY:  | JM     | CHK. BY: | RMB    |

CADD FILE:  
1162.6-PC-PV-09.dwg

DATE: 09/11/23


SCALE:  
AS SHOWN

DRAWING NO.


**PC - 9**




FILE: 1162.6-PC-PV-10.dwg

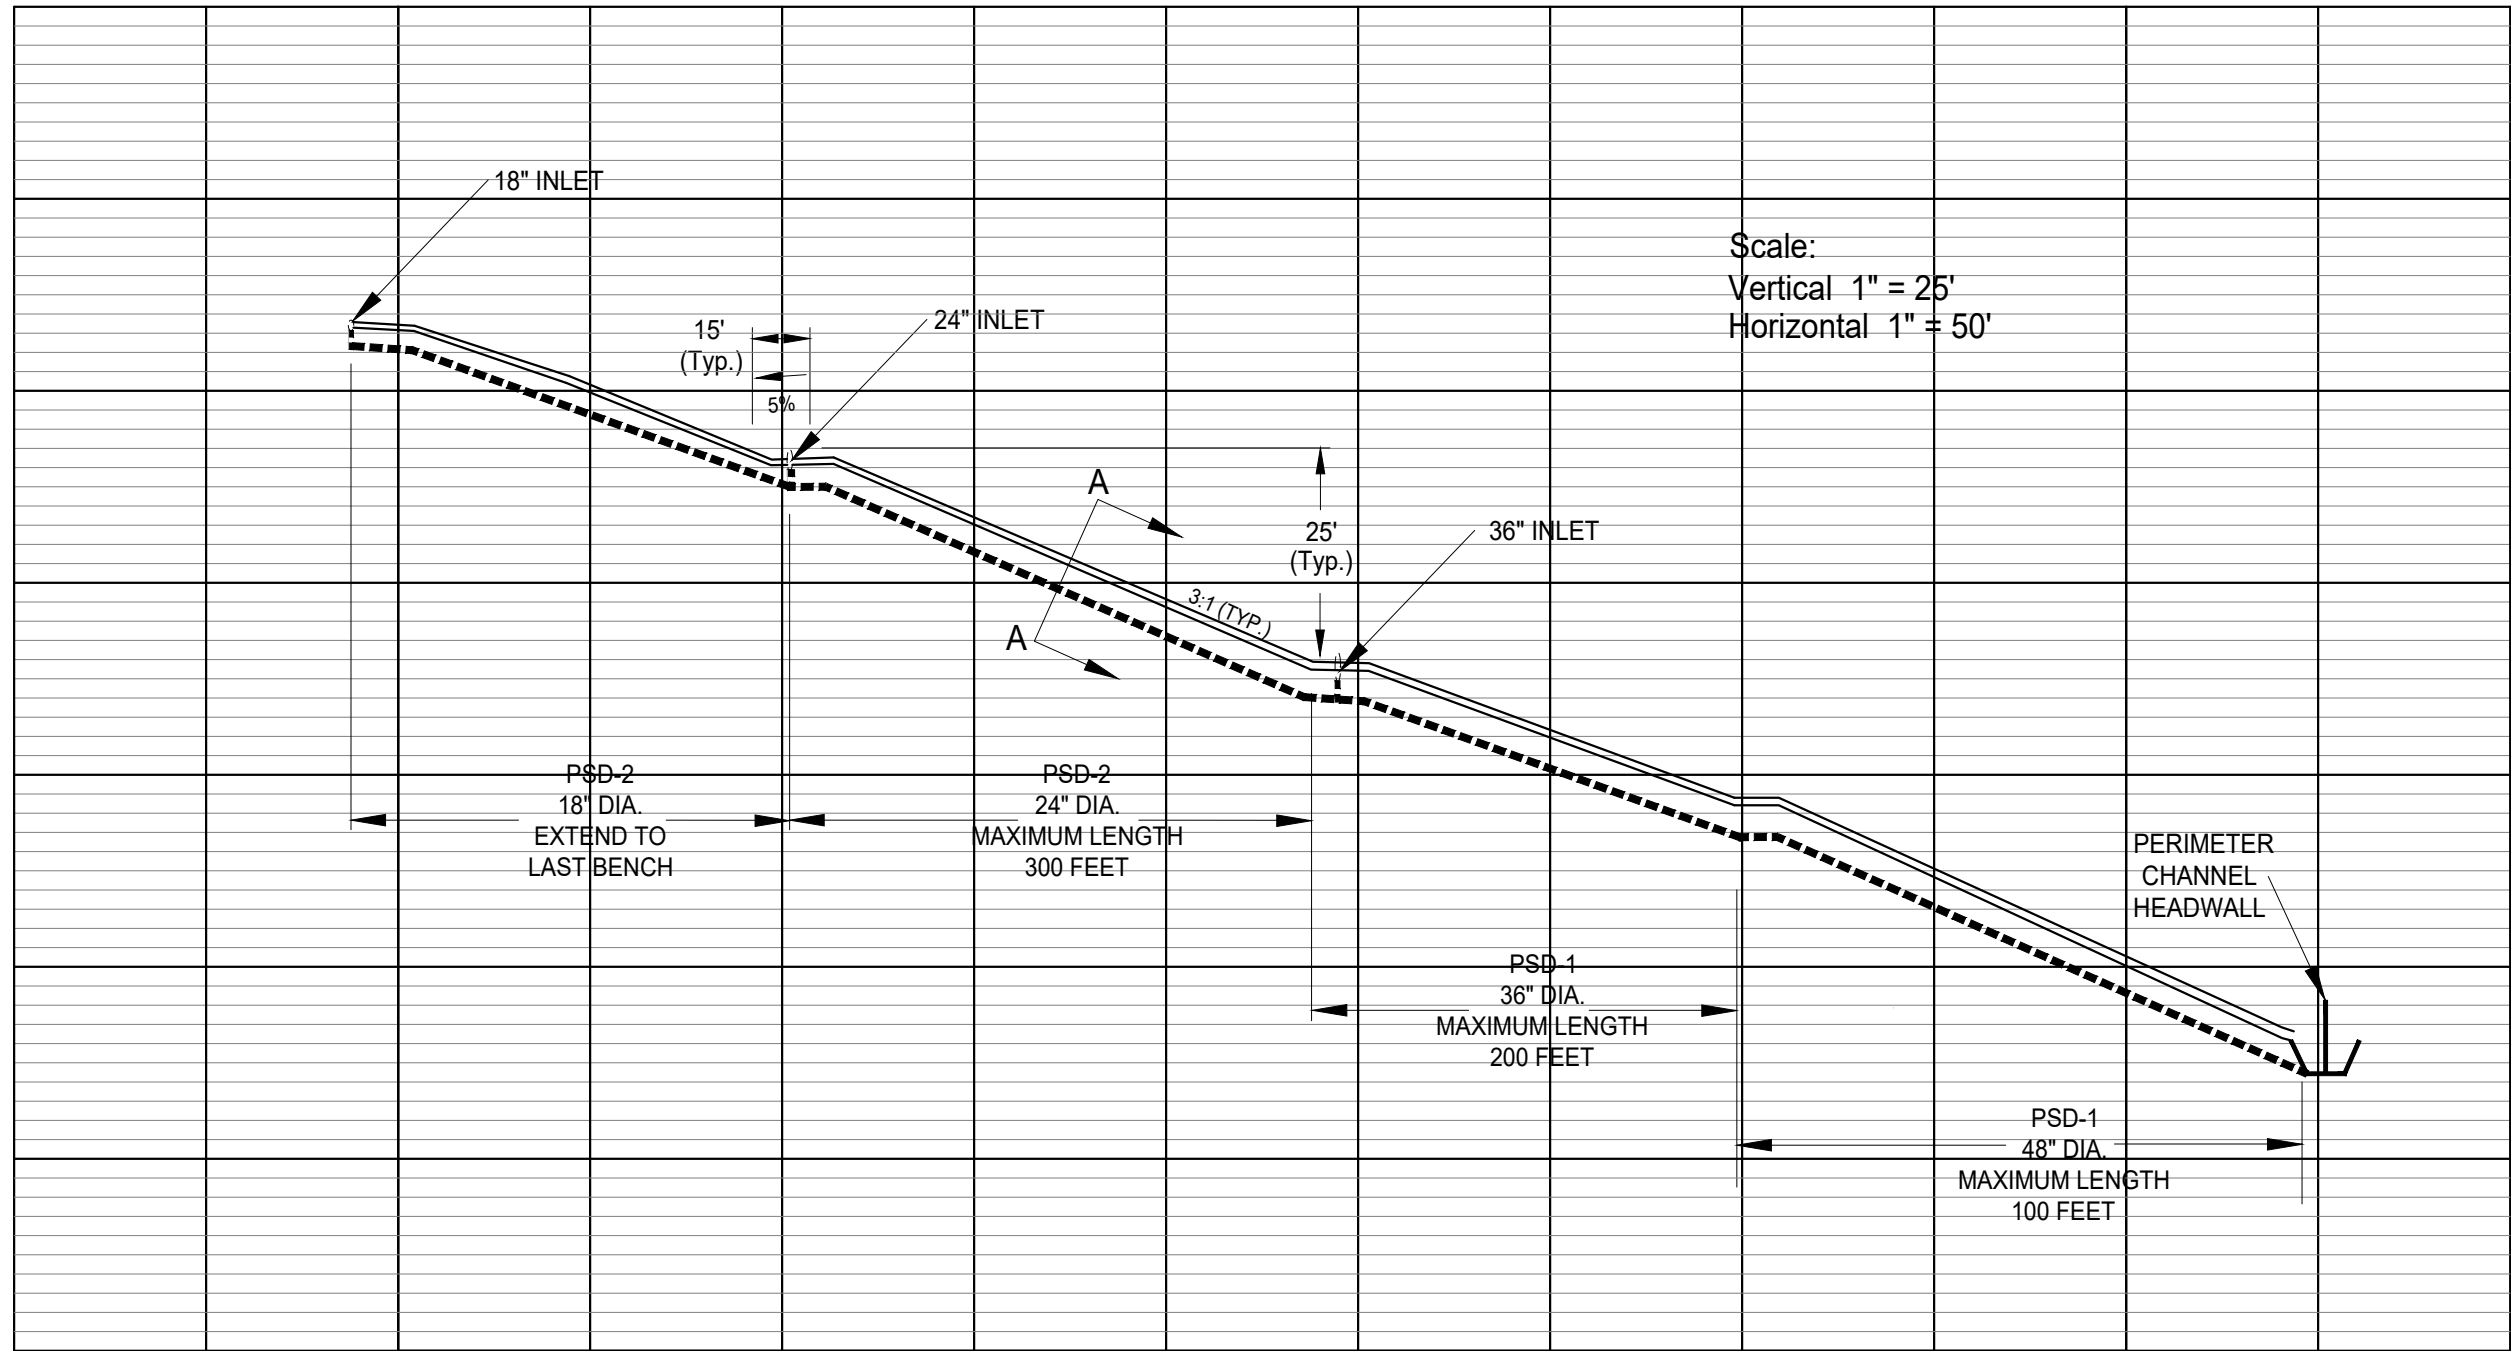


TYPICAL PIPE SLOPE DRAIN PROFILE AND SIZING

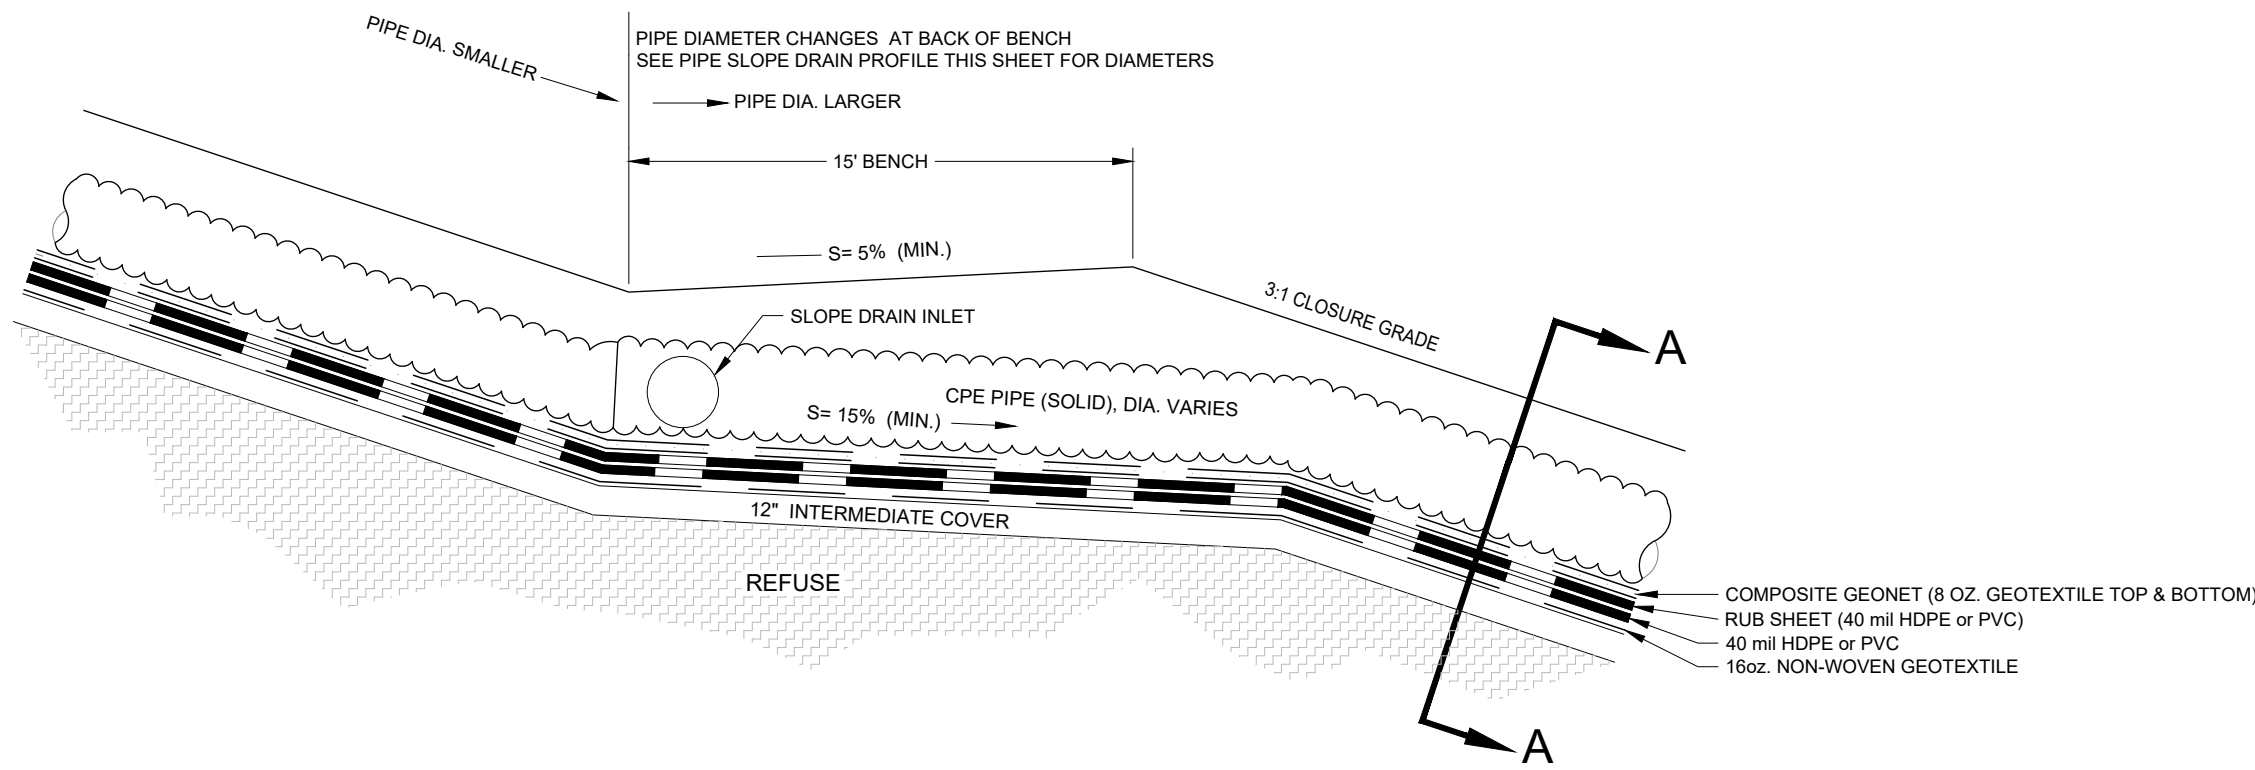

TYPICAL PIPE SLOPE DRAIN PROFILE  
SCALE: NTS

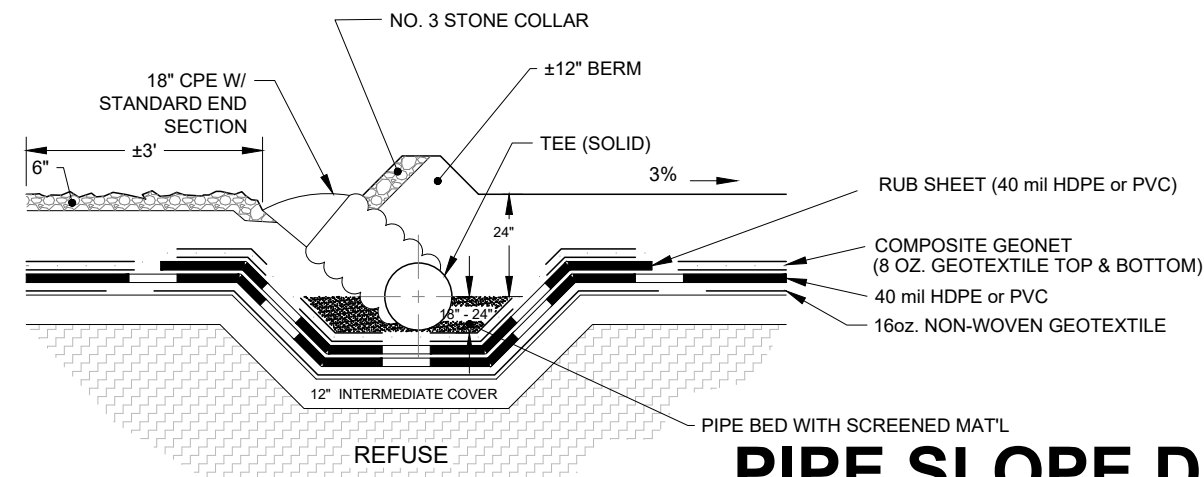

PIPE SLOPE DRAIN INLET  
SCALE: NTS

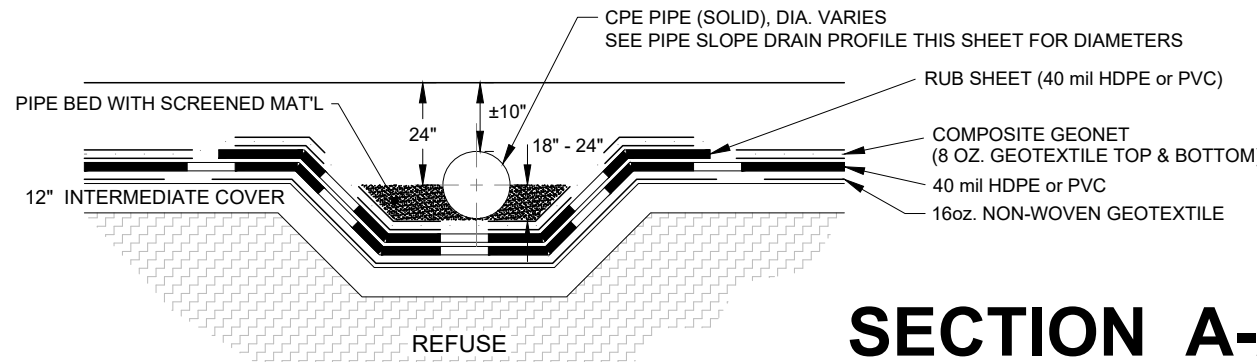

SECTION A-A  
SCALE: NTS



| NO. | REVISION | DATE |
|-----|----------|------|
|     |          |      |
|     |          |      |
|     |          |      |
|     |          |      |

ALTERNATE TO DOWNSLOPE DRAIN

POST CONSTRUCTION STORMWATER MANAGEMENT DETAILS

PHASE V EXPANSION

Bethlehem Landfill Company

NORTHAMPTON CO.  
LOWER SAUCON TWP.  
PENNSYLVANIA

martin and martin incorporated

37 south main street • suite A  
phone: (717) 264-6759  
chambersburg, pennsylvania 17201

|           |        |          |    |        |
|-----------|--------|----------|----|--------|
| PROJ. NO. | 1162.6 | DSN. BY: | JM | MSH/DB |
| CHK. BY:  |        |          |    | RMB    |

CADD FILE:  
1162.6-PC-PV-10.dwg


DATE:  
09/11/23

SCALE:  
AS SHOWN

DRAWING NO.

PC - 10



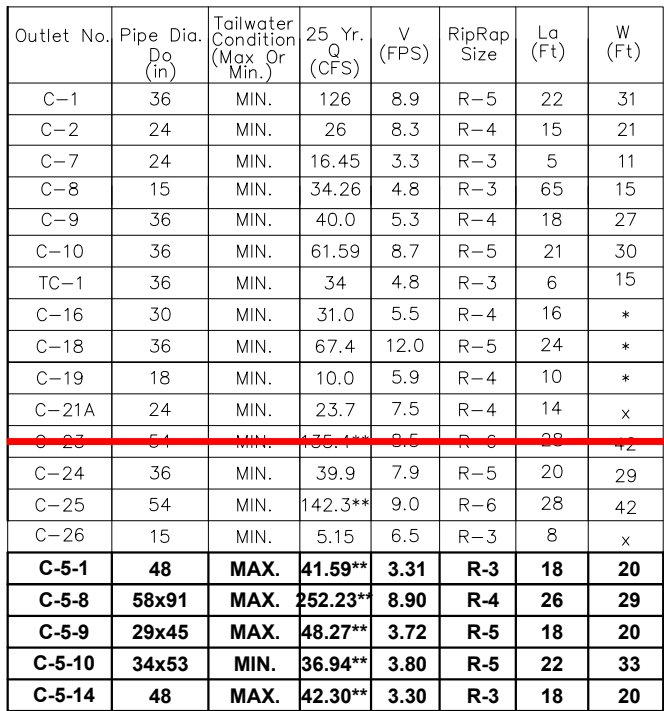

C-1 = NO MODIFICATIONS

~~C-23~~ = DELETED AS A RESULT OF PHASE V EXPANSION

C-5-14 = ADDED DATA FOR PHASE V EXPANSION

NO SCALE

Diagram illustrating the correct fit of a grate into a grate holder. The grate is shown being inserted into the holder. A circular area on the grate is shaded with diagonal lines and labeled "See Note".

ISOMETRIC VIEW



| CURT NO. | SIZE (IN.)  | MATERIAL | LENGTH (FT.) | SLUICE (FT./CFS) | UPSTREAM INVERT (FT./MSLL) | DOWNSIDE INVERT (FT./MSLL) | Q <sub>DES</sub> (CFS) | INLET STRUCTURE  | OUTLET STRUCTURE | OUTLET PROTECTION | VELOCITY FLOWING FULL (FPS) |
|----------|-------------|----------|--------------|------------------|----------------------------|----------------------------|------------------------|------------------|------------------|-------------------|-----------------------------|
| C-1      | 24" 36"     | CMP      | 39           | 0.023            | 457.00                     | 456.10                     | 152.6                  | TYPE M           | TYPE D-ENLOWALL  | RIPRAP            | 14.9                        |
| C-2      | 24" 24"     | CMP      | 13           | 0.109            | 448.6                      | 434.38                     | 13.9                   | MH #1            | TYPE D-ENLOWALL  | RIPRAP            | 12.5                        |
| C-3      | 24" RCP     | 468      | 0.02         | 458.00           | 448.70                     | 33.9                       | MH #2                  | MH #2            | ---              | 11.0              | ---                         |
| C-4      | 24" RCP     | 250      | 0.145        | 494.35           | 458.10                     | 22.7                       | TYPE M                 | MH #2            | ---              | 14.9              | ---                         |
| C-5      | 18" CMP     | 30       | 0.110        | 427.00           | 423.70                     | 4.5                        | TYPE D-ENLOWALL        | TYPE M           | ---              | 9.6               | ---                         |
| C-5o     | 21" RCP     | 215      | 0.005        | 424.80           | 423.70                     | 8.70                       | TYPE M                 | TYPE M           | ---              | 4.9               | ---                         |
| C-6      | 24" RCP     | 60       | 0.005        | 423.70           | 423.40                     | 10.85                      | TYPE M                 | TYPE M           | ---              | 5.5               | ---                         |
| C-7      | 24" RCP     | 803      | 0.005        | 423.40           | 423.00                     | 13.00                      | TYPE M                 | TYPE D-ENLOWALL  | RIPRAP           | 14.9              | ---                         |
| C-8      | 15" RCP     | 82       | 0.18         | 480.00           | 430.0                      | 3.8                        | TYPE M                 | TYPE D-ENLOWALL  | RIPRAP           | 12.5              | ---                         |
| C-9      | 36" RCP     | 60       | 0.05         | 506.00           | 503.00                     | 52.9                       | 2-M                    | TYPE D-ENLOWALL  | RIPRAP           | 14.0              | ---                         |
| C-14     | 15" HDPEEP  | 416      | 0.016        | 564.75           | 648.25                     | 4.1                        | TYPE M                 | INLET TYPE M     | ---              | 3.2               | ---                         |
| C-15     | 30" HDPEEP  | 396      | 0.01         | 646.93           | 642.97                     | 26.9                       | TYPE M                 | INLET TYPE M     | ---              | 5.5               | ---                         |
| C-16     | 36" HDPEEP  | 530.2    | 0.07         | 642.97           | 638.44                     | 31.6                       | TYPE M                 | TYPE D-ENLOWALL  | RIPRAP           | 14.9              | ---                         |
| C-17     | 48" HDPEEP  | 287      | 0.01         | 625.39           | 621.72                     | 10.69                      | MH #3                  | MH #3            | ---              | 8.1               | ---                         |
| C-17a    | 48" HDPEEP  | 39       | 0.009        | 629.29           | 626.09                     | 10.89                      | TYPE D-ENLOWALL        | TYPE D-ENLOWALL  | RIPRAP           | 14.9              | ---                         |
| C-18     | 36" HDPEEP  | 235      | 0.033        | 624.52           | 627.06                     | 67.4                       | 2-M                    | TYPE M           | ---              | 10.0              | ---                         |
| C-18     | 36" HDPEEP  | 235      | 0.042        | 625.66           | 627.20                     | 67.4                       | MH #4                  | TYPE M           | TYPE D-ENLOWALL  | RIPRAP            | 12.5                        |
| C-19     | 18" HDPEEP  | 138      | 0.02         | 623.92           | 621.17                     | 10.03                      | TYPE M                 | TYPE D-ENLOWALL  | RIPRAP           | 5.89              | ---                         |
| C-20     | 24" HDPEEP  | 71       | 0.037        | 633.09           | 626.09                     | 23.70                      | TYPE M                 | MH #3            | ---              | 10.02             | ---                         |
| C-22     | 36" HDPEEP  | 100      | 0.034        | 597.00           | 596.00                     | 135.39                     | MH #1                  | TYPE D-ENLOWALL  | RIPRAP           | 14.9              | ---                         |
| C-23     | 36" HDPEEP  | 206      | 0.035        | 601.80           | 597.00                     | 135.39                     | MH #10                 | MH #11           | ---              | 8.69              | ---                         |
| C-24     | 36" HDPEEP  | 294      | 0.029        | 617.02           | 603.20                     | 102.97                     | MH #2                  | MH #10           | ---              | 8.69              | ---                         |
| C-24     | 36" HDPEEP  | 314      | 0.019        | 513.50           | 507.60                     | 62.13                      | TYPE M                 | MH #12           | ---              | 6.8               | ---                         |
| C-24     | 36" HDPEEP  | 202      | 0.037        | 498.50           | 494.00                     | 62.13                      | MH #12                 | ---              | ---              | 10.8              | ---                         |
| C-24     | 36" HDPEEP  | 202      | 0.119        | 493.90           | 470.00                     | 62.13                      | MH #13                 | TYPE D-ENLOWALL  | RIPRAP           | 7.9               | ---                         |
| C-25     | 54" HDPEEP  | 30       | 0.025        | 471.50           | 470.75                     | 142.25                     | TYPE M                 | TYPE D-ENLOWALL  | RIPRAP           | 8.99              | ---                         |
| C-25     | 54" HDPEEP  | 124      | 0.067        | 480.00           | 471.75                     | 142.25                     | TYPE M                 | TYPE M           | ---              | 8.99              | ---                         |
| C-25     | 54" HDPEEP  | 30       | 0.183        | 490.00           | 484.50                     | 142.25                     | TYPE DW-ENLOWALL       | TYPE M           | ---              | 8.99              | ---                         |
| C-26     | 18" HDPEEP  | 216      | 0.092        | 534.50           | 513.60                     | 2.85                       | TYPE M                 | TYPE M           | ---              | 8.99              | ---                         |
| C-5-1    | 48" HDPEEP  | 50       | 0.020        | 682.00           | 681.00                     | 41.99                      | TYPE D-ENLOWALL        | TYPE D-ENLOWALL  | RIPRAP           | 3.6               | ---                         |
| C-5-2    | 36" HDPEEP  | 80       | 0.038        | 586.00           | 583.00                     | 48.89                      | TYPE D-ENLOWALL        | TYPE D-ENLOWALL  | ---              | 6.5               | ---                         |
| C-5-3    | 24" HDPEEP  | 0.033    | 581.00       | 450.00           | 25.20                      | TYPE D-ENLOWALL            | TYPE D-ENLOWALL        | ---              | 8.0              | ---               |                             |
| C-5-4    | 58"X91" RCP | 40       | 0.050        | 392.00           | 389.00                     | 255.15                     | TYPE DW-ENLOWALL       | TYPE M-1-5-1     | ---              | 8.9               | ---                         |
| C-5-6    | 58"X91" RCP | 80       | 0.080        | 399.00           | 395.00                     | 252.23                     | TYPE M-1-5-1           | TYPE M-1-5-2     | ---              | 8.9               | ---                         |
| C-5-8    | 58"X91" RCP | 40       | 0.010        | 399.00           | 365.00                     | 252.23                     | TYPE M-1-5-2           | TYPE M-1-5-3     | ---              | 8.9               | ---                         |
| C-5-7    | 58"X91" RCP | 50       | 0.200        | 352.00           | 342.00                     | 252.23                     | TYPE M-1-5-3           | TYPE M-1-5-4     | ---              | 8.9               | ---                         |
| C-5-8    | 58"X91" RCP | 50       | 0.160        | 330.00           | 322.00                     | 252.23                     | TYPE M-1-5-4           | TYPE D-ENLOWALL  | RIPRAP           | 8.9               | ---                         |
| C-5-9    | 29"X45" RCP | 160      | 0.005        | 352.80           | 352.00                     | 20.94                      | TYPE DW-ENLOWALL       | TYPE D-ENLOWALL  | RIPRAP           | 3.0               | ---                         |
| C-5-10   | 14"X33" RCP | 48       | 0.04         | 414.00           | 612.00                     | 36.00                      | TYPE DW-ENLOWALL       | TYPE DW-ENLOWALL | RIPRAP           | 3.8               | ---                         |
| C-5-11   | 45" HDPEEP  | 25       | 0.025        | 465.00           | 463.00                     | 41.30                      | TYPE D-ENLOWALL        | TYPE M-1-5-5     | ---              | 8.9               | ---                         |
| C-5-12   | 48" HDPEEP  | 113      | 0.008        | 455.00           | 454.10                     | 42.13                      | TYPE M-1-5-5           | MH-5.1           | ---              | 3.3               | ---                         |
| C-5-13   | 48" HDPEEP  | 100      | 0.080        | 454.00           | 476.00                     | 42.30                      | MH-5.1                 | MH-5.2           | ---              | 3.3               | ---                         |
| C-5-14   | 48" HDPEEP  | 25       | 0.040        | 465.00           | 464.00                     | 42.30                      | MH-5.2                 | TYPE D-ENLOWALL  | RIPRAP           | 3.3               | ---                         |

C-19 = NO MODIFICATIONS

~~C-23~~ = DELETED AS A RESULT OF PHASE V EXPANSION

**C-5-14** = ADDED DATA FOR PHASE V EXPANSION

1. HDPE - HIGH DENSITY POLYETHYLENE PIPE, CMP - POLYMER COATED CORRUGATED METAL PIPE, RCP - REINFORCED CONCRETE PIPE, TYPE "D" AND "B"-W ENDSALLS SHALL BE CONSTRUCTED IN ACCORDANCE WITH PENNDOT PUBLICATION 408 SECTION 605 AND STANDARDS FOR ROADWAY CONSTRUCTION CH. 408.
4. PROVIDE INLET BOX AND TON UNIT FOR STORM INLETS #1 AND #5 WITH OPENINGS TO ACCOMMODATE A DOUBLE GRATE.
5. ALL STORM INLETS AND CATCH BASINS SHALL BE CONSTRUCTED IN ACCORDANCE WITH PENNDOT PUBLICATION 408 SECTION 605 AND STANDARDS FOR ROADWAY CONSTRUCTION.
6. PRECAST MANHOLES TO BE CONSTRUCTED IN ACCORDANCE WITH PENNDOT PUBLICATION 408 SECTION 605 AND STANDARDS FOR ROADWAY CONSTRUCTION.
7. ALL STORM MANHOLE TOPS SHALL BE POLISHED TO MATCH WITH HIGHER SHALL BE SAW CUT AT THE ENDS AS NEEDED AND NOT HAMMERED OR BROKEN
8. ALL RCP SHALL BE CLASS 3 REINFORCED CONCRETE PIPE WITH O-RING JOINTS.
9. ALL ENDSALLS SHALL BE CONSTRUCTED WITH FROST PROOFING WALL EXTENDING A MIN. OF 2 FEET BELOW FINISHED GRADE.
10. ALL STORMWATER MANHOLES ARE REQUIRED TO CONTAIN A DISC INDICATING A PROHIBITION AGAINST POLLUTANTS.
11. ALL STORMWATER PIPING SHALL HAVE WATER TIGHT JOINTS.

| INLET NO. | TOP OF GRAVE ELEV. | INLET ELEV. |        | INLET TYPE    | PIPE DIA. | DOWNSIDE STRUCTURE |
|-----------|--------------------|-------------|--------|---------------|-----------|--------------------|
|           |                    | IN          | OUT    |               |           |                    |
| #1        | 461.10             | ----        | 457.00 | M (3)         | (2) 36"   | BASIN #4           |
| #2        | 499.50             | ----        | 495.00 | M             | 15"       | BASIN #6           |
| #3        | 511.70             | 508.00      | 498.00 | 2" PRECAST MK | 30"       | BASIN #6           |
| #6        | 428.80             | ----        | 424.80 | M             | 24"       | INLET #7           |
| #7        | 428.80             | ----        | 423.70 | M             | 24"       | INLET #8           |
| #8        | 428.80             | ----        | 423.40 | M             | 24"       | BASIN #3           |
| #9        | 590.00             | ----        | 580.90 | D-H           | 24"       | INLET #5           |
| #10       | 657.50             | ----        | 654.75 | TYPE M        | 15"       | #11                |
| #11       | 651.00             | 648.25      | 646.93 | TYPE M        | 30"       | #12                |
| #12       | 650.50             | 642.97      | 642.87 | TYPE M        | 30"       | CHANNEL C          |
| #13       | 468.79             | ----        | 465.50 | 2" PRECAST MK | 36"       | CHANNEL C          |
| #14       | 625.42             | ----        | 623.92 | TYPE M        | 18"       | SED TRAP           |
| #15       | 533.00             | ----        | 529.00 | M             | 24"       | INLET #2           |
| #16       | 521.25             | 513.60      | 513.50 | TYPE M        | 36"       | MH #3              |
| #18       | 661.40             | 654.17      | 644.57 | TYPE M        | 24"       | CHANNEL Y          |
| #19       | 537.95             | ----        | 534.50 | TYPE M        | 18"       | 1-I-6              |
| #20       | 479.00             | 471.75      | 471.50 | TYPE M        | 48"       | BASIN #2           |
| #21       | 490.00             | 484.50      | 480.00 | TYPE M        | 48"       | INLET #20          |
| #24       | 384.00             | 388.00      | 388.00 | TYPE M        | 58x91"    | BASIN #8           |
| #25       | 396.00             | 395.00      | 389.00 | TYPE M        | 58x91"    | INLET #3           |
| #26       | 396.00             | 395.00      | 389.00 | TYPE M        | 58x91"    | INLET #4           |
| #5-3      | 372.00             | 365.00      | 352.00 | TYPE M        | 58x91"    | INLET #4           |
| #5-4      | 350.00             | 342.00      | 330.00 | TYPE M        | 58x91"    | BASIN #8           |
| MH #1     | 465.00             | 448.70      | 444.60 | PRECAST MH    | 24"       | OUTLET             |
| MH #2     | 470.00             | 458.10      | 458.00 | PRECAST MH    | 24"       | MH #1              |
| MH #3     | 524.88             | 526.68      | 527.68 | PRECAST MH    | 36"       | MH #2              |
| MH #4     | 462.23             | 457.86      | 456.86 | PRECAST MH    | 30"       | CHANNEL C          |
| MH #5     | 459.00             | 451.69      | 451.67 | PRECAST MH    | 30"       | CHANNEL C          |
| MH #6     | 654.50             | 644.97      | 644.93 | PRECAST MH    | 30"       | CHANNEL C          |
| MH #7     | 653.44             | 641.98      | 641.94 | PRECAST MH    | 30"       | CHANNEL C          |
| MH #8     | 654.02             | 640.31      | 640.27 | PRECAST MH    | 30"       | CHANNEL C          |
| MH #9     | 650.94             | 638.22      | 638.18 | PRECAST MH    | 30"       | CHANNEL C          |
| MH#10     | 609.25             | 603.50      | 603.40 | PRECAST MH    | 48"       | MH #11             |
| MH#11     | 654.50             | 599.00      | 598.90 | PRECAST MH    | 48"       | CHANNEL N          |
| MH#12     | 511.00             | 507.60      | 496.50 | PRECAST MH    | 36"       | MH#13              |
| MH#13     | 513.00             | 494.00      | 493.90 | PRECAST MH    | 36"       | BASIN #2           |
| MH#5-1    | 506.00             | 484.10      | 484.00 | PRECAST MH    | 48"       | MH-5-2             |
| MH#5-2    | 482.00             | 476.00      | 465.00 | PRECAST MH    | 48"       | BASIN #6           |

|                   |                                            |
|-------------------|--------------------------------------------|
| #16               | = NO MODIFICATIONS                         |
| <del>MISS 1</del> | = DELETED AS A RESULT OF PHASE V EXPANSION |
| #5-4              | = ADDED DATA FOR PHASE V EXPANSION         |

1. TYPE "M" AND "D-H" INLETS AND CATCH BASINS SHALL BE CONSTRUCTED IN ACCORDANCE WITH PENNDOT PUBLICATION 408 SECTION 605 AND STANDARDS FOR ROADWAY CONSTRUCTION.
2. PRECAST MANHOLES AND INLETS TO BE CONSTRUCTED IN ACCORDANCE WITH PENNDOT PUBLICATION 408 SECTION 605 AND STANDARDS FOR ROADWAY CONSTRUCTION.
3. ALL STORMWATER PIPING SHALL HAVE WATERTIGHT JOINTS.
4. ALL INLETS AND STORMWATER MANHOLES ARE REQUIRED TO CONTAIN A DISK INDICATING A PROHIBITION AGAINST POLLUTANTS.

## POST CONSTRUCTION STORMWATER MANAGEMENT DETAILS

NORTHAMPTON CO.

## PHASE V EXPANSION

**LOWER SAUCON TWP.**

264-6759 chambersburg, pennsylvania . 17201

phone: (717) 37 south main street • suite A  
264-6759 chambersburg, pennsylvania • 17201

CADD FILE:  
1162.6-PC-PV-11.dwg


DATE: 09/11/23

SCALE: AS SHOWN

DRAWING NO.

**PC - 11**




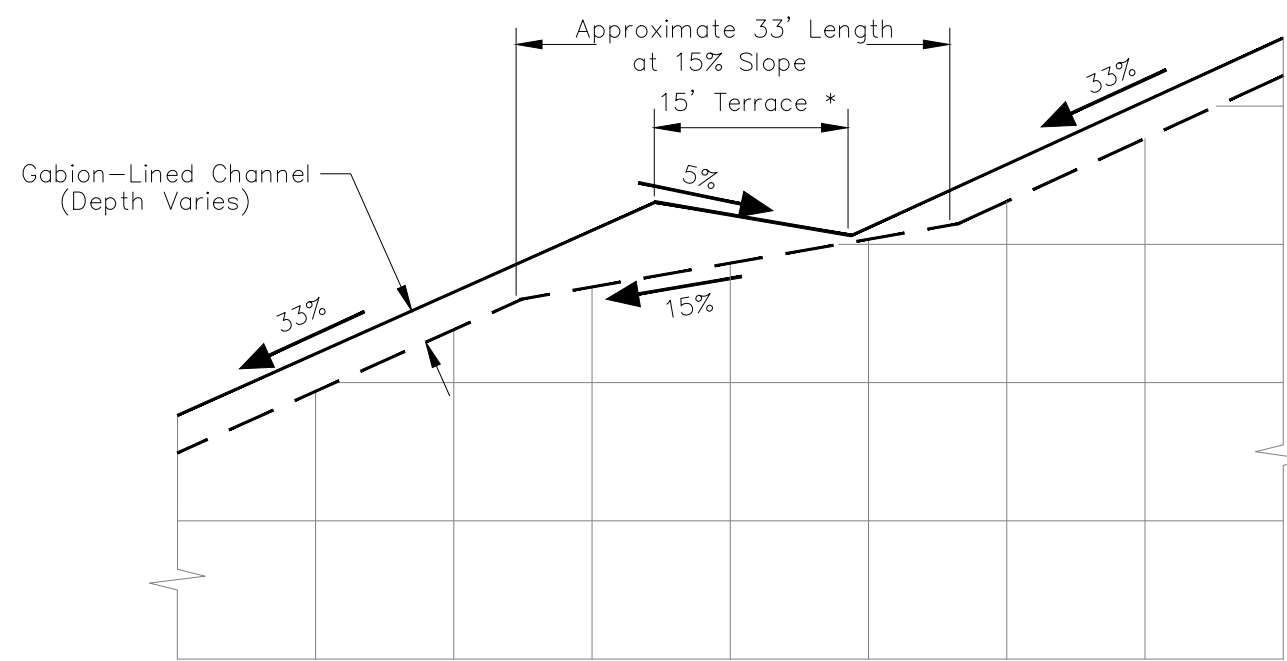


BENCH SECTION A-A  
Not to Scale

WATERWAY RIPRAP  
DIMENSION TABLE


| NSA NO. | d <sub>50</sub> | THICKNESS |
|---------|-----------------|-----------|
| R-3     | 3"              | 9"        |
| R-4     | 6"              | 18"       |
| R-5     | 9"              | 27"       |
| R-6     | 12"             | 36"       |
| R-7     | 15"             | 45"       |

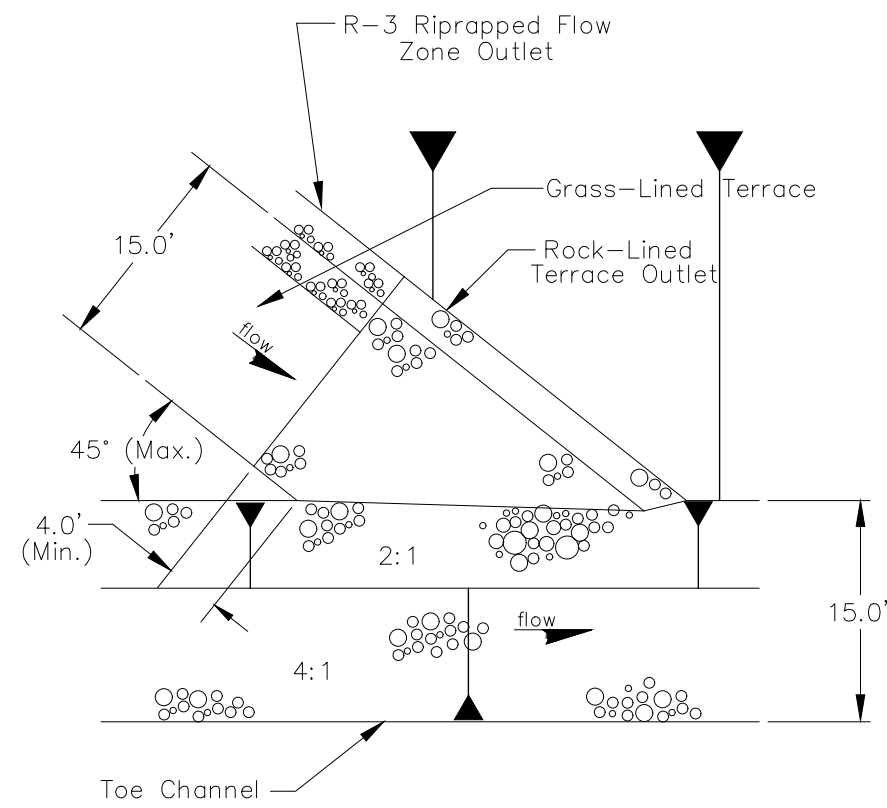


LANDFILL BENCH / CHANNEL CONNECTION  
Not to Scale

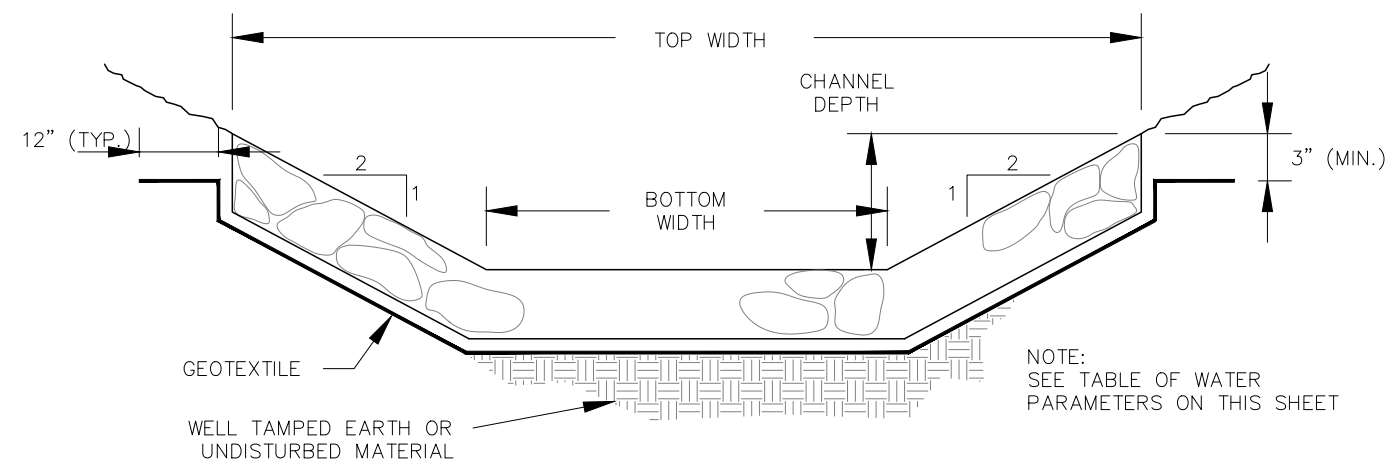


TYPICAL TRAPEZOIDAL  
RIPRAP CHANNEL  
NO SCALE

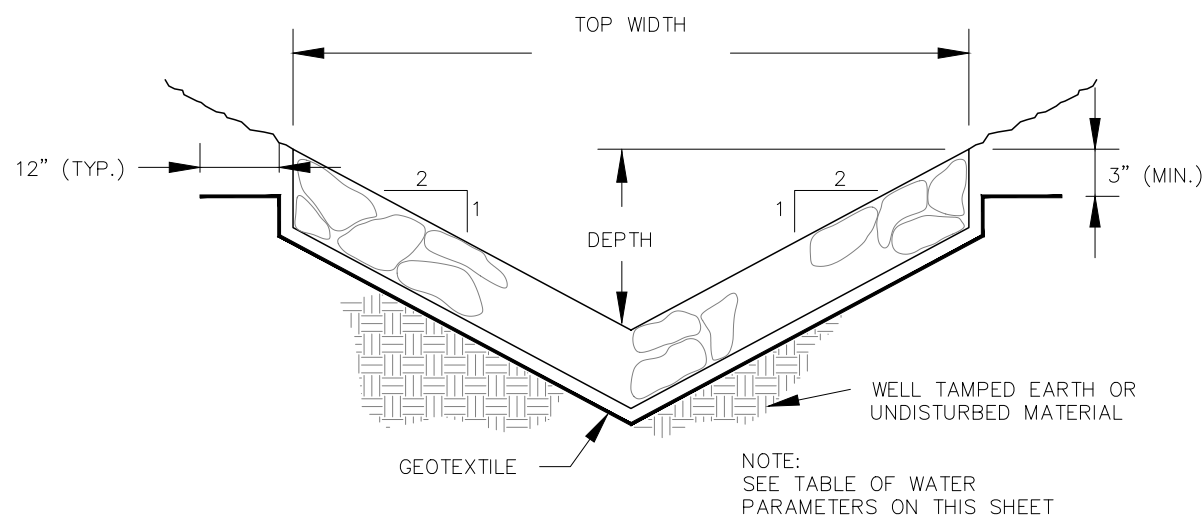

TYPICAL TRIANGULAR  
RIPRAP SWALE  
NO SCALE

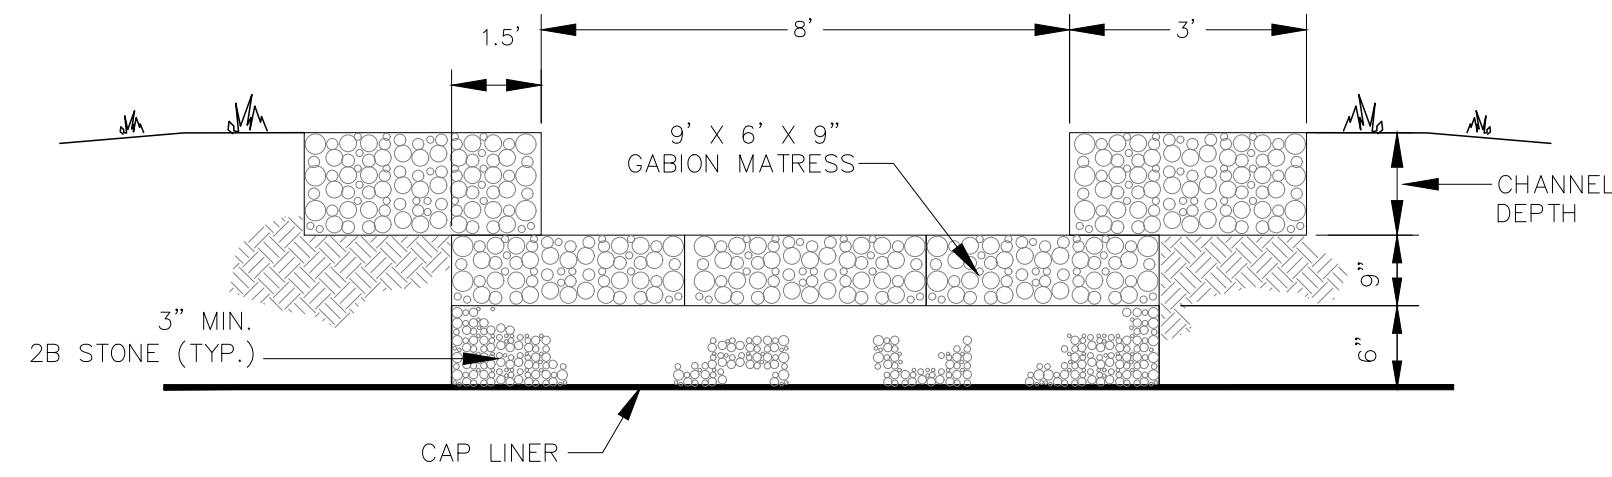

TYPICAL GABION SLOPEDRAIN DETAIL  
NO SCALE

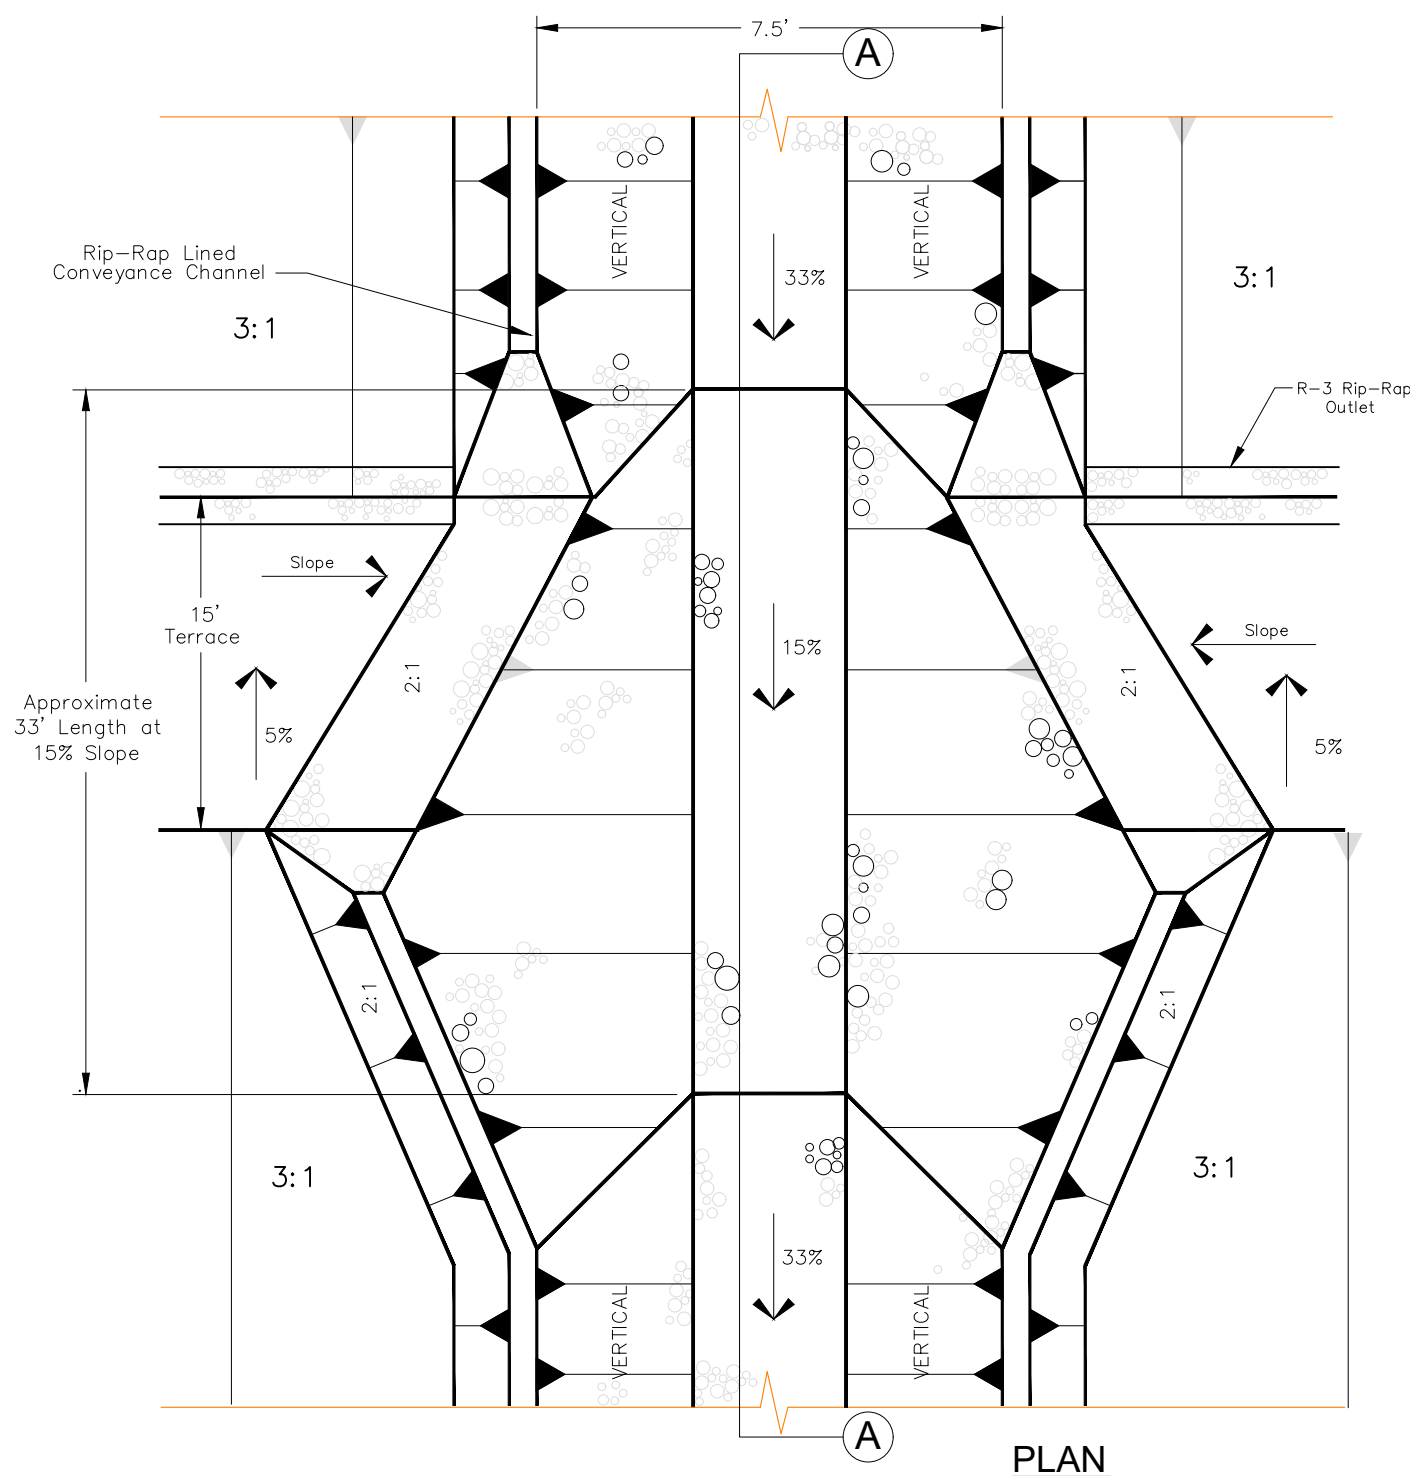

DOWNSLOPE / TERRACE INTERFACE  
Not to Scale

## SUMMARY HYDRAULIC DESIGN OF PERMANENT / TEMPORARY WATERWAYS

| CHANNEL NO.    | CHANNEL STATION | AVG. SLOPE (FT./FT.) | TYPE  | SIDE SLOPES (H:V) | BOTTOM WIDTH (FT) | CHANNEL DEPTH (FT) | TOP WIDTH (FT) | Q100 (CFS) | DEPTH D100 (FT) | VELOCITY V100 (FT/SEC) | MAX. ALLOWABLE VELOCITY (FT/SEC) | PROTECTIVE LINING |
|----------------|-----------------|----------------------|-------|-------------------|-------------------|--------------------|----------------|------------|-----------------|------------------------|----------------------------------|-------------------|
| A (1)          | 0+00-8+20       | 0.05                 | TRAPE | 2:1               | 4.0               | 2.0                | 12.0           | 10         | 0.4             | 5.3                    | 6.5                              | R-3               |
| A (1)          | 8+20-12+50      | 0.02                 | TRAPE | 2:1               | 4.0               | 2.0                | 12.0           | 10         | 0.51            | 3.9                    | 4.5                              | R-3               |
| B (1)          | 0+00-3+00       | 0.05                 | TRAPE | 2:1               | 4.0               | 2.0                | 12.0           | 3.8        | 0.36            | 2.3                    | 4.0                              | GRASS             |
| C (1)          | 0+00-5+50       | 0.20                 | TRAPE | 2:1               | 6.0               | 2.0                | 13.1           | 52.8       | 0.70            | 8.8                    | 11.5                             | R-5               |
| C (1)          | 5+50-7+00       | 0.05                 | TRAPE | 2:1               | 6.0               | 2.0                | 13.1           | 52.8       | 1.01            | 6.5                    | 6.5                              | R-3               |
| E (1)          | 0+00-4+50       | 0.015                | TRAPE | 2:1               | 4.0               | 3.0                | 16.00          | 10.3       | 1.81            | 5.7                    | 6.5                              | R-3               |
| G (1)          | 0+00-1+20       | 0.029                | V     | 2:1               | ---               | 2.0                | 8.0            | 1.24       | 0.65            | 1.5                    | 4.0                              | GRASS             |
| H (1)          | 0+00-2+50       | 0.01                 | V     | 2:1               | ---               | 2.0                | 8.0            | 2.98       | 1.05            | 1.34                   | 4.0                              | GRASS             |
| K (1)          | 0+00-1+90       | 0.04                 | TRAPE | 2:1               | 4.0               | 2.0                | 12.0           | 33.9       | 0.95            | 6.1                    | 6.5                              | R-3               |
| M (1)          | 0+00-0+63       | 0.040                | TRI   | 2:1               | ---               | 3.0                | 9.5            | 15.5       | 2.31            | 4.52                   | 6.5                              | R-3               |
| M (1)          | 0+63-1+90       | 0.118                | TRI   | 2:1               | ---               | 3.0                | 9.5            | 15.5       | 2.08            | 6.58                   | 6.5                              | R-3               |
| M (1)          | 1+90-2+97       | 0.047                | TRI   | 2:1               | ---               | 3.0                | 9.5            | 15.5       | 2.31            | 4.52                   | 6.5                              | R-3               |
| M (1)          | 2+97-8+54       | 0.074                | TRI   | 2:1               | ---               | 3.0                | 9.5            | 15.5       | 2.31            | 4.52                   | 6.5                              | R-3               |
| M (1)          | 8+54-9+64       | 0.023                | TRI   | 2:1               | ---               | 3.0                | 9.5            | 15.5       | 2.31            | 4.52                   | 6.5                              | R-3               |
| N (1)          | 0+00-3+91       | 0.243                | TRAPE | 2:1               | 2.0               | 3.0                | 13.3           | 134.55     | 1.83            | 13.02                  | 15.0                             | R-7               |
| N (1)          | 3+91-4+24       | 0.167                | TRAPE | 2:1               | 2.0               | 3.0                | 13.3           | 134.55     | 1.79            | 13.43                  | 15.0                             | R-7               |
| S (1)          | 0+00-BASIN 4    | 2                    | TRAP  | 2:1               | 8.0               | 2.5                | 16.8           | 67.4       | 1.53            | 5.4                    | 6.5                              | R-3               |
| BERM SWALE (1) | ALL             | ALL                  | TRI   | 3:1               | 0.0               | 1.7                | 10.0           | 3.4        | .67             | 4.56                   | 6.5                              | R-3               |
| U              | 0+00-6+00       | 0.030                | TRI   | 3:1               | 0                 | 1.90               | 15.0           | 14         | 0.9             | 4.6                    | 6.5                              | R-3               |
| V (1)          | 0+00-1+25       | 0.008                | TRI   | 2:1               | ---               | 2.0                | 8.0            | 1.81       | 0.60            | 2.53                   | 6.5                              | R-3               |
| V (1)          | 1+25-2+85       | 0.03                 | TRI   | 2:1               | ---               | 2.0                | 8.0            | 1.81       | 0.60            | 2.53                   | 6.5                              | R-3               |
| V (1)          | 2+85-3+10       | 0.10                 | TRI   | 2:1               | ---               | 2.0                | 8.0            | 1.81       | 0.60            | 2.53                   | 6.5                              | R-3               |
| Z (1)          | 0+00-0+56       | 0.054                | TRI   | 2:1               | ---               | 2.0                | 7.5            | 3.24       | 0.65            | 3.50                   | 6.5                              | R-3               |
| Z (1)          | 0+56-3+16       | 0.015                | TRI   | 2:1               | ---               | 2.0                | 7.5            | 3.24       | 0.76            | 2.78                   | 6.5                              | R-3               |
| Z (1)          | 3+16-4+16       | 0.095                | TRAP  | 2:1               | 0.10              | 2.0                | 7.5            | 3.24       | 0.57            | 4.54                   | 6.5                              | R-3               |
| AA             | 0+00-2+90       | 0.044                | TRI   | 2:1               | 0                 | 1.5                | 7.5            | 0.97       | 0.60            | 2.10                   | 6.5                              | R-3               |
| BB             | 0+00-1+11       | 0.005                | TRAP  | 2:1               | 2.0               | 3.0                | 17.3           | 96.32      | 2.62            | 4.95                   | 6.5                              | R-3               |
| CC             | 0+00-19+40      | 0.005                | TRAP  | 2:1               | 2.0               | 3.2                | 14.9           | 58.26      | 2.21            | 4.09                   | 6.5                              | R-3               |
| 5-A            | 0+00 - 7+50     | 0.100                | TRAP  | 2:1               | 4.0               | 2.0                | 12.0           | 18.92      | 0.57            | 6.42                   | 6.5                              | R-3               |
| 5-A            | 7+50 - 9+81     | 0.040                | TRAP  | 2:1               | 6.0               | 2.0                | 14.0           | 18.92      | 0.99            | 2.40                   | 6.5                              | R-3               |
| 5-B            | 0+00 - 6+09     | 0.021                | TRAP  | 2:1               | 4.0               | 2.0                | 12.0           | 17.08      | 0.86            | 3.45                   | 4.0                              | GRASS             |
| 5-C            | 0+00 - 13+56    | 0.024                | TRAP  | 2:1               | 6.0               | 2.5                | 16.0           | 48.27      | 1.08            | 5.45                   | 6.5                              | R-3               |
| 5-D            | 0+00 - 10+50    | 0.015                | TRAP  | 2:1               | 10.0              | 3.5                | 24.0           | 249.81     | 2.53            | 6.56                   | 9.0                              | R-4               |
| 5-D            | 10+50 - 16+48   | 0.150                | TRAP  | 2:1               | 10.0              | 2.5                | 20.0           | 119.99     | 1.09            | 9.06                   | 11.5                             | R-5               |
| 5-E            | 0+00 - 2+00     | 0.250                | TRAP  | 2:1               | 4.0               | 2.0                | 12.0           | 4.74       | 0.24            | 4.51                   | 6.5                              | R-3               |
| 5-F            | 0+00 - 6+71     | 0.200                | TRAP  | 2:1               | 4.0               | 2.0                | 12.0           | 25.26      | 0.65            | 7.35                   | 9.0                              | R-4               |
| 5-G            | 0+00 - 7+78     | 0.110                | TRAP  | 2:1               | 4.0               | 2.0                | 12.0           | 36.13      | 0.89            | 7.07                   | 9.0                              | R-4               |
| 5-H            | 0+00 - 6+76     | 0.106                | TRI   | 2:1               | ---               | 2.0                | 8.0            | 5.00       | 0.68            | 5.36                   | 6.5                              | R-3               |
| 5-I            | 0+00 - 8+50     | 0.180                | TRAP  | 2:1               | 6.0               | 2.0                | 16.0           | 41.07      | 0.71            | 7.80                   | 9.0                              | R-4               |
| 5-I            | 8+50 - 10+51    | 0.040                | TRAP  | 2:1               | 6.0               | 2.0                | 16.0           | 41.07      | 0.89            | 5.97                   | 6.5                              | R-3               |
| 5-J            | 0+00 - 2+16     | 0.100                | TRAP  | 2:1               | 6.0               | 2.0                | 16.0           | 2.28       | 0.14            | 2.65                   | 4.0                              | GRASS             |
| DIV#1 (1)      | 0+00-3+50       | 4.0                  | V     | 2:1               | ---               | 3.0                | 12.0           | 12.38*     | 1.71*           | 4.34*                  | 5.0                              | GRASS             |
| DS-1A          | 0+00-2+83       | 0.26                 | RECT. | ---               | 8.0               | 2.0                | 8.0            | 72.5*      | 0.9*            | 10.1*                  | 14.5                             | GABION            |
| DS-1*(1)       | 0+00-8+28       | 0.28                 | RECT. | ---               | 8.0               | 2.0                | 8.0            | 72.5*      | 0.9*            | 10.1*                  | 14.5                             | GABION            |
| DS-2*(1)       | 0+00-6+17       | 0.28                 | RECT. | ---               | 8.0               | 2.0                | 8.0            | 44.0*      | 0.62*           | 8.8*                   | 14.5                             | GABION            |
| DS-3*(1)       | 0+00-1+59       | 0.28                 | RECT. | ---               | 6                 | 1.5                | 6.0            | 20.4*      | 0.5             | 6.86                   | 14.5                             | GABION            |
| DS-4           | ---             | 0.42                 | RECT. | ---               | 8                 | 2.4                | 8.0            | 152.6      | 1.4             | 13.8                   | 14.5                             | GABION            |
| DS-5*          | 0+00-1+06       | 0.26                 | RECT. | ---               | 6                 | 1.5                | 6.0            | 20.4*      | 0.5             | 6.86                   | 14.5                             | GABION            |
| DS-6(1)        | 0+00-6+25       | 0.28                 | RECT. | ---               | 8.00              | 2.0                | 8.00           | 43.96      | 0.62            | 8.84                   | 14.5                             | GABION            |
| DS-7(1)        | 0+00-2+45       | 0.20                 | RECT. | ---               | 6.00              | 2.0                | 6.00           | 33.79      | 0.59            | 7.13                   | 14.5                             | GABION            |
| DS-8           | 0+00-3+09       | 0.28                 | RECT. | ---               | 8.0               | 2.0                | 8.0            | 44.22      | 0.62            | 8.86                   | 14.5                             | GABION            |
| DS-9           | 0+00-11+44      | 0.28                 | RECT. | ---               | 8.0               | 2.0                | 8.0            | 26.36      | 0.48            | 8.81                   | 14.5                             | GABION            |
| 5-DS-A         | 0+00 - 6+50     | 0.28                 | RECT. | ---               | 8.0               | 2.0                | 8.0            | 44.20      | 0.62            | 8.86                   | 14.5                             | GABION            |
| 5-DS-B         | 0+00 - 14+39    | 0.28                 | RECT. | ---               | 8.0               | 2.0                | 8.0            | 44.20      | 0.62            | 8.86                   | 14.5                             | GABION            |
| 5-DS-C         | 0+00 - 5+81     | 0.28                 | RECT. | ---               | 8.0               | 2.0                | 8.0            | 44.20      | 0.62            | 8.86                   | 14.5                             | GABION            |
| 5-DS-D         | 0+00 - 13+88    | 0.28                 | RECT. | ---               | 8.0               | 2.0                | 8.0            | 44.20      | 0.62            | 8.86                   | 14.5                             | GABION            |
| 5-DS-E         | 0+00 - 20+90    | 0.28                 | RECT. | ---               | 8.0               | 2.0                | 8.0            | 44.20      | 0.62            | 8.86                   | 14.5                             | GABION            |
| 5-DS-F         | 0+00 - 19+86    | 0.28                 | RECT. | ---               | 8.0               | 2.0                | 8.0            | 44.20      | 0.62            | 8.86                   | 14.5                             | GABION            |
| 5-DS-G         | 0+00 - 14+53    | 0.28                 | RECT. | ---               | 8.0               | 2.0                | 8.0            | 44.20      | 0.62            | 8.86                   | 14.5                             | GABION            |
| 5-DS-H         | 0+00 - 5+22     | 0.28                 | RECT. | ---               | 8.0               | 2.0                | 8.0            | 44.20      | 0.62            | 8.86                   | 14.5                             | GABION            |
| 5-DS-I         | 0+00 - 2+20     | 0.28                 | RECT. | ---               | 8.0               | 2.0                | 8.0            | 44.20      | 0.62            | 8.86                   | 14.5                             | GABION            |


~~DS-7(1)~~ = DELETED AS A RESULT OF PHASE V EXPANSION

**5-DS-E** = ADDED DATA FOR PHASE V EXPANSION

V = EXISTING CHANNEL (NO CHANGE)

NOTES:

- CHANNEL IS NOT PART OF OVERALL CONVEYANCE SYSTEM THUS Q, DEPTH AND VELOCITY ARE BASED ON THE 25 YEAR / 24 HOUR STORM EVENT
- SLOPE DRAIN DESIGNED TO CONVEY MAX. Q100 OF 44.2 CFS.

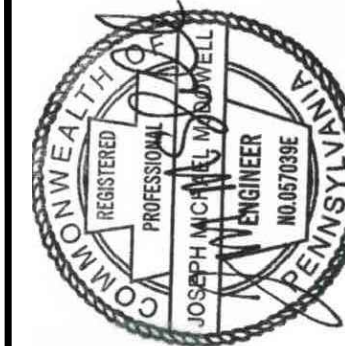

| DATE     |  |
|----------|--|
| REVISION |  |
| NO.      |  |

POST CONSTRUCTION STORMWATER MANAGEMENT DETAILS  
NORTHAMPTON CO.  
PHASE V EXPANSION  
Bethlehem Landfill Company  
PENNSYLVANIA  
LOWER SAUCON TWP.

**MMI** martin and martin incorporated  
phone: (717) 37 south main street • suite A  
264-6759 chambersburg, pennsylvania . 17201  
PROJ. NO. 1162.6 DWN. BY: MSH/DB  
DWN. BY: JIM CHK. BY: RMB  
SCALE: AS SHOWN

CADD FILE:  
1162.6-PC-PV-12.dwg

DATE:  
09/11/23


SCALE:  
AS SHOWN

DRAWING NO.


PC - 12




FILE: 1162.6-PC-PV-13.dwg

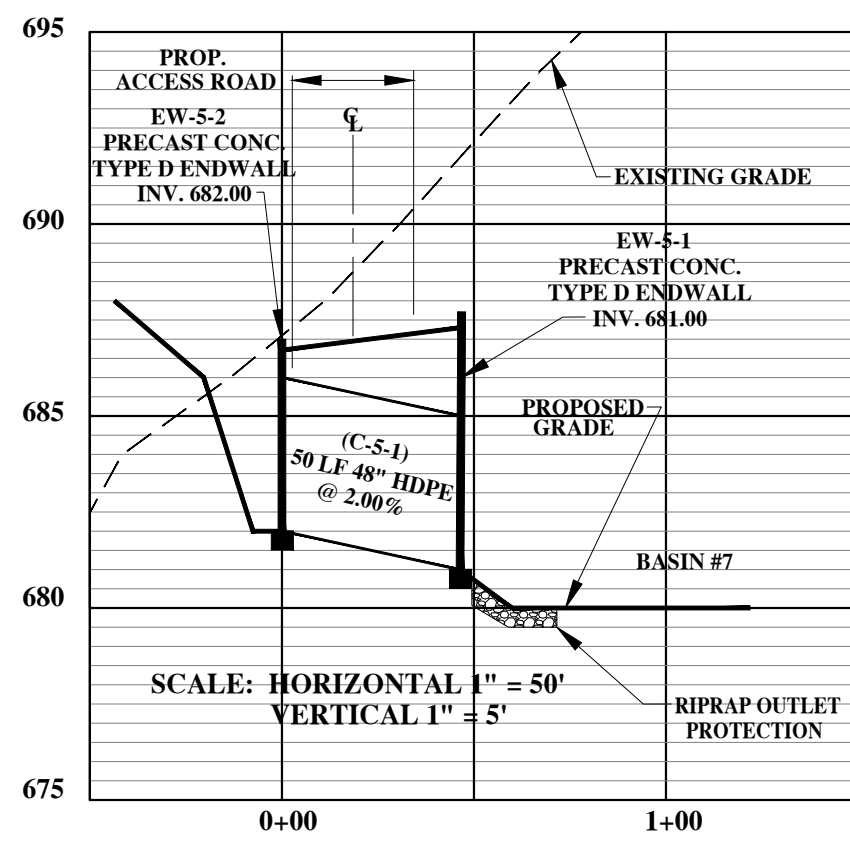


C-5-1 PROFILE

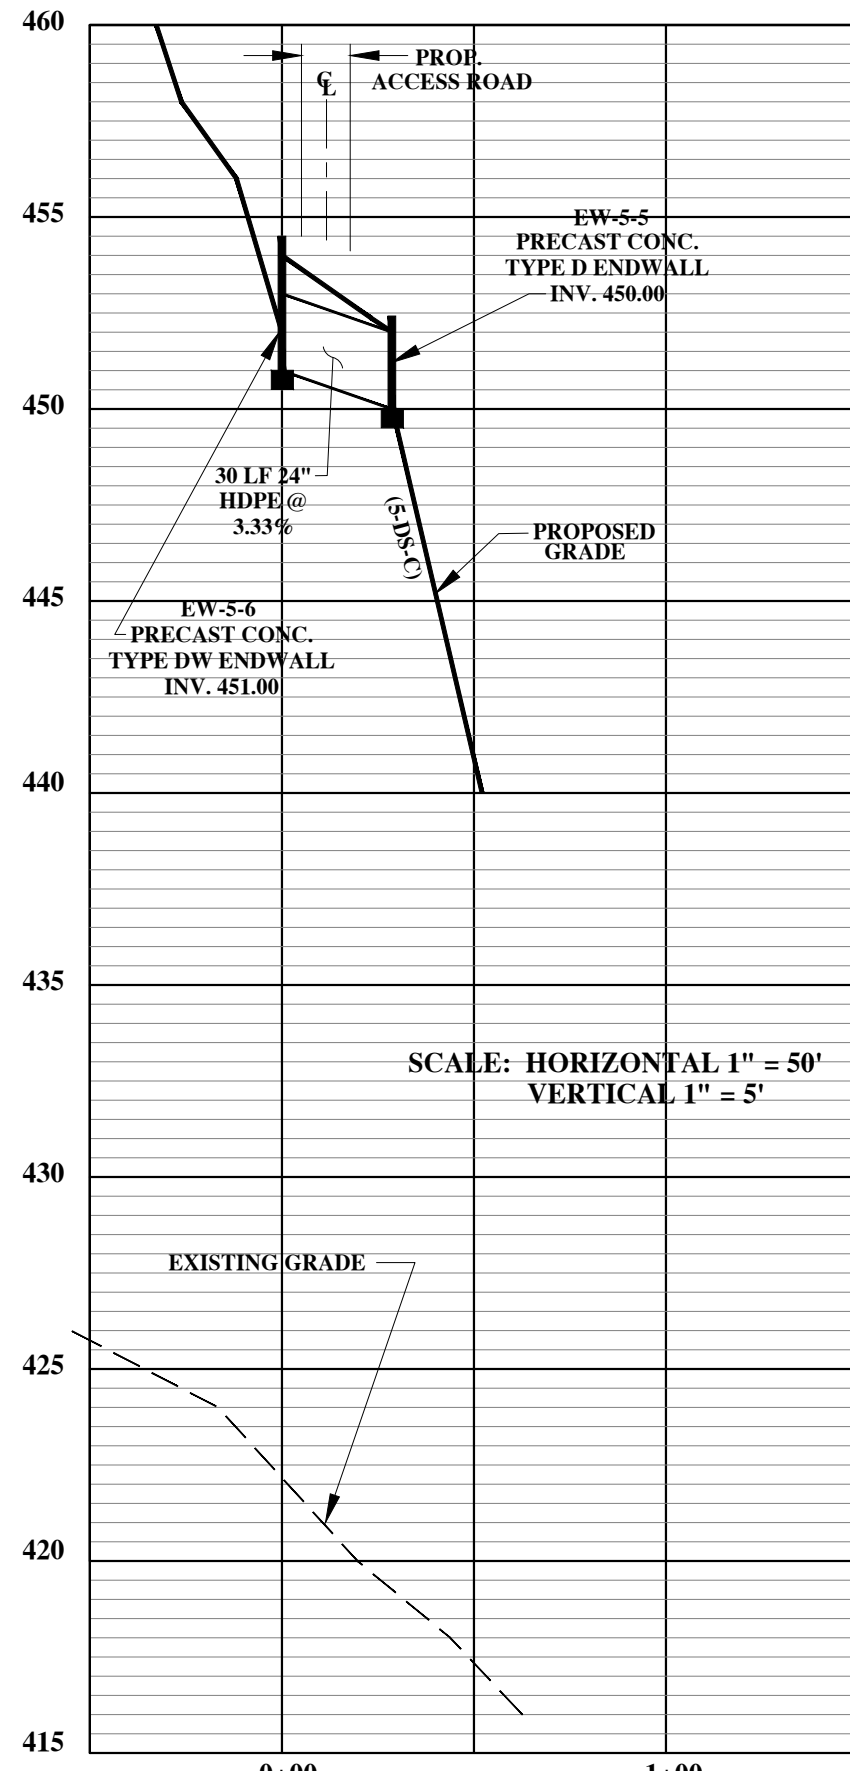


C-5-3 PROFILE

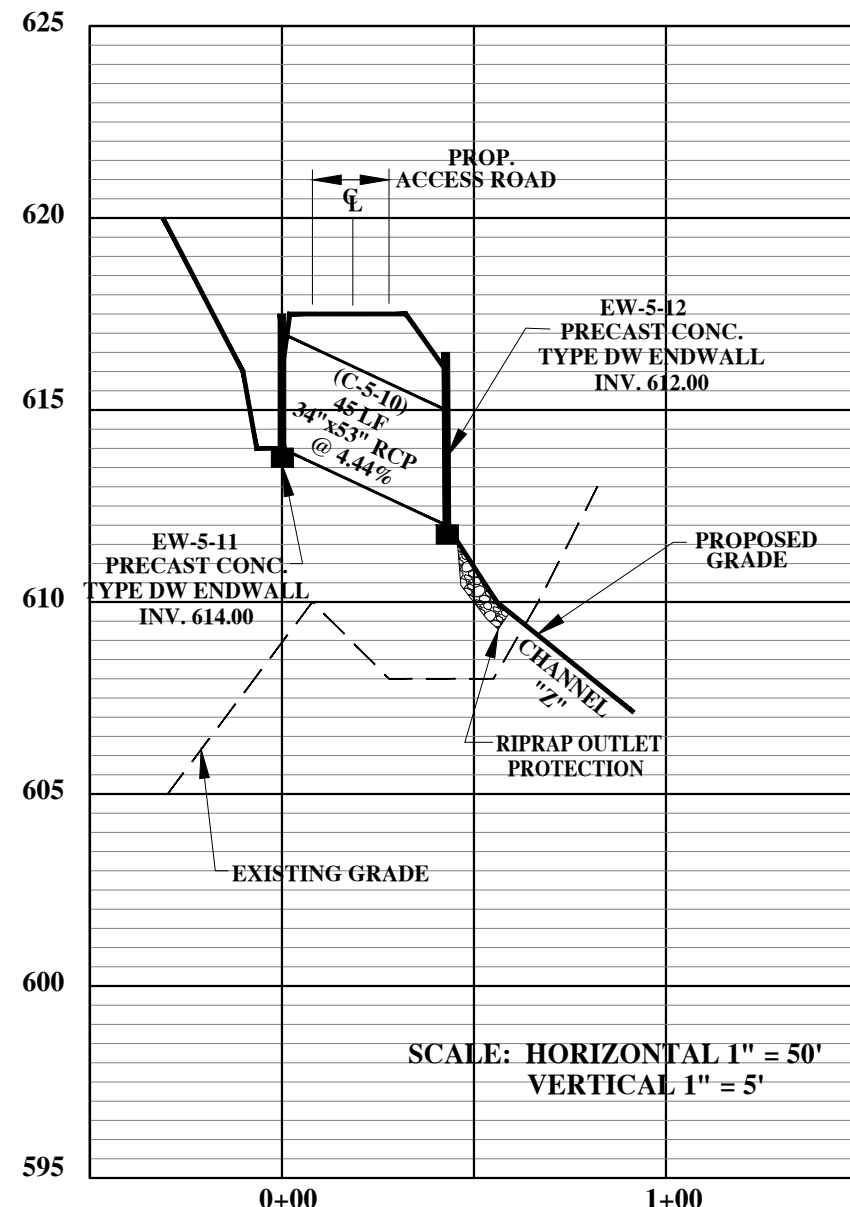


C-5-10 PROFILE

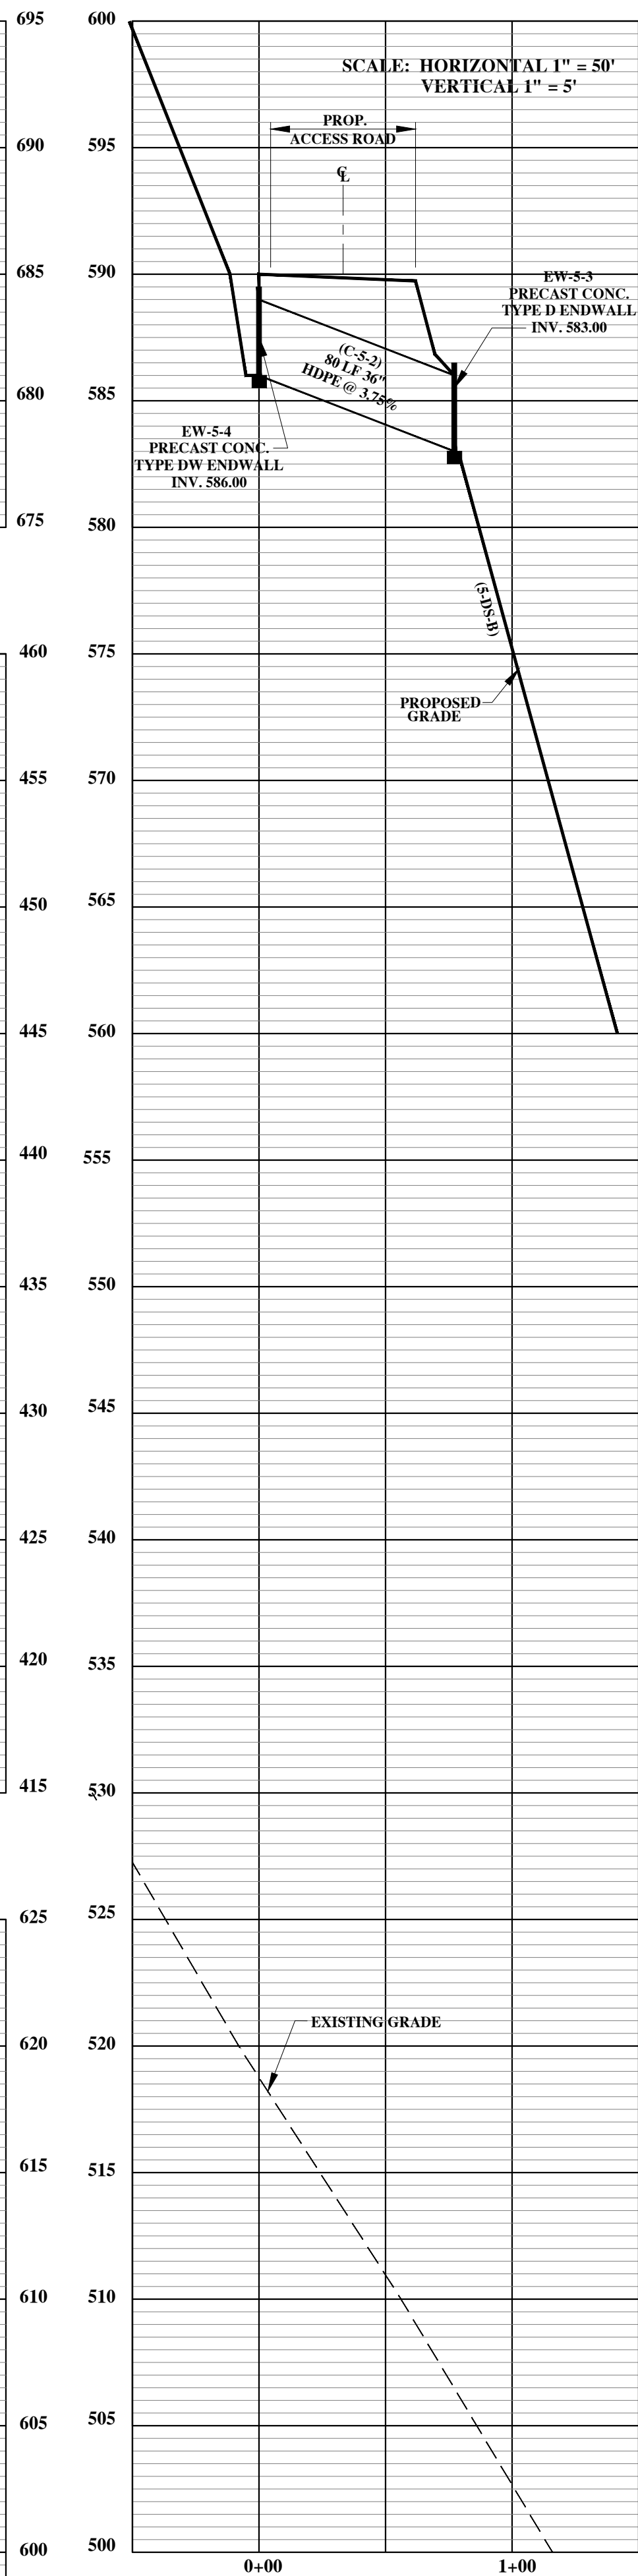


C-5-2 PROFILE

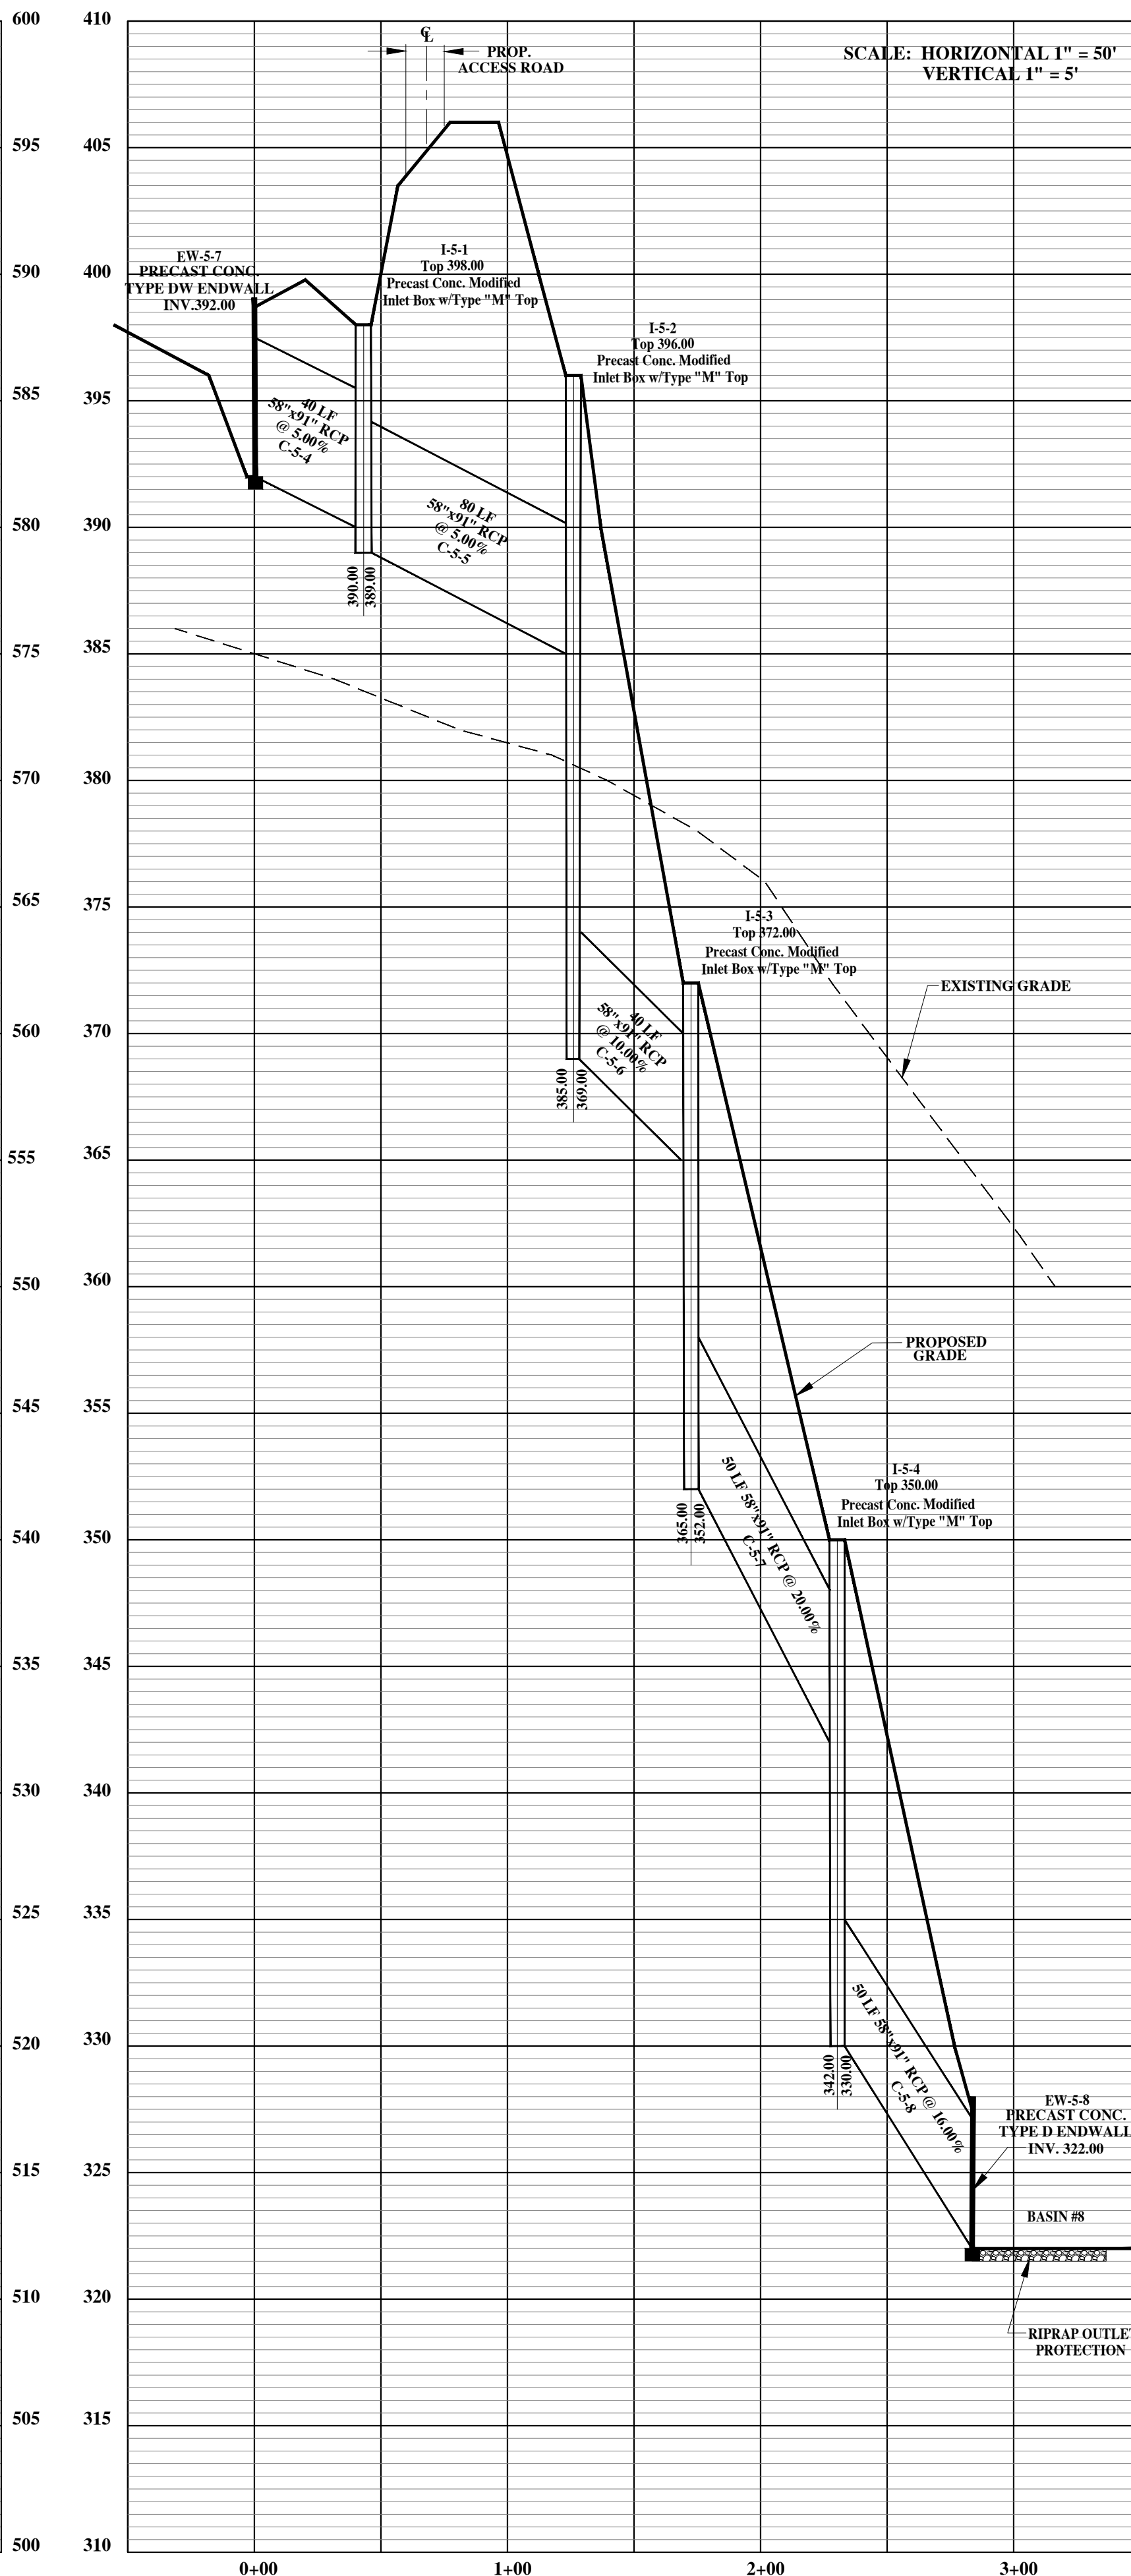

C-5-4 TO C-5-8 PROFILE

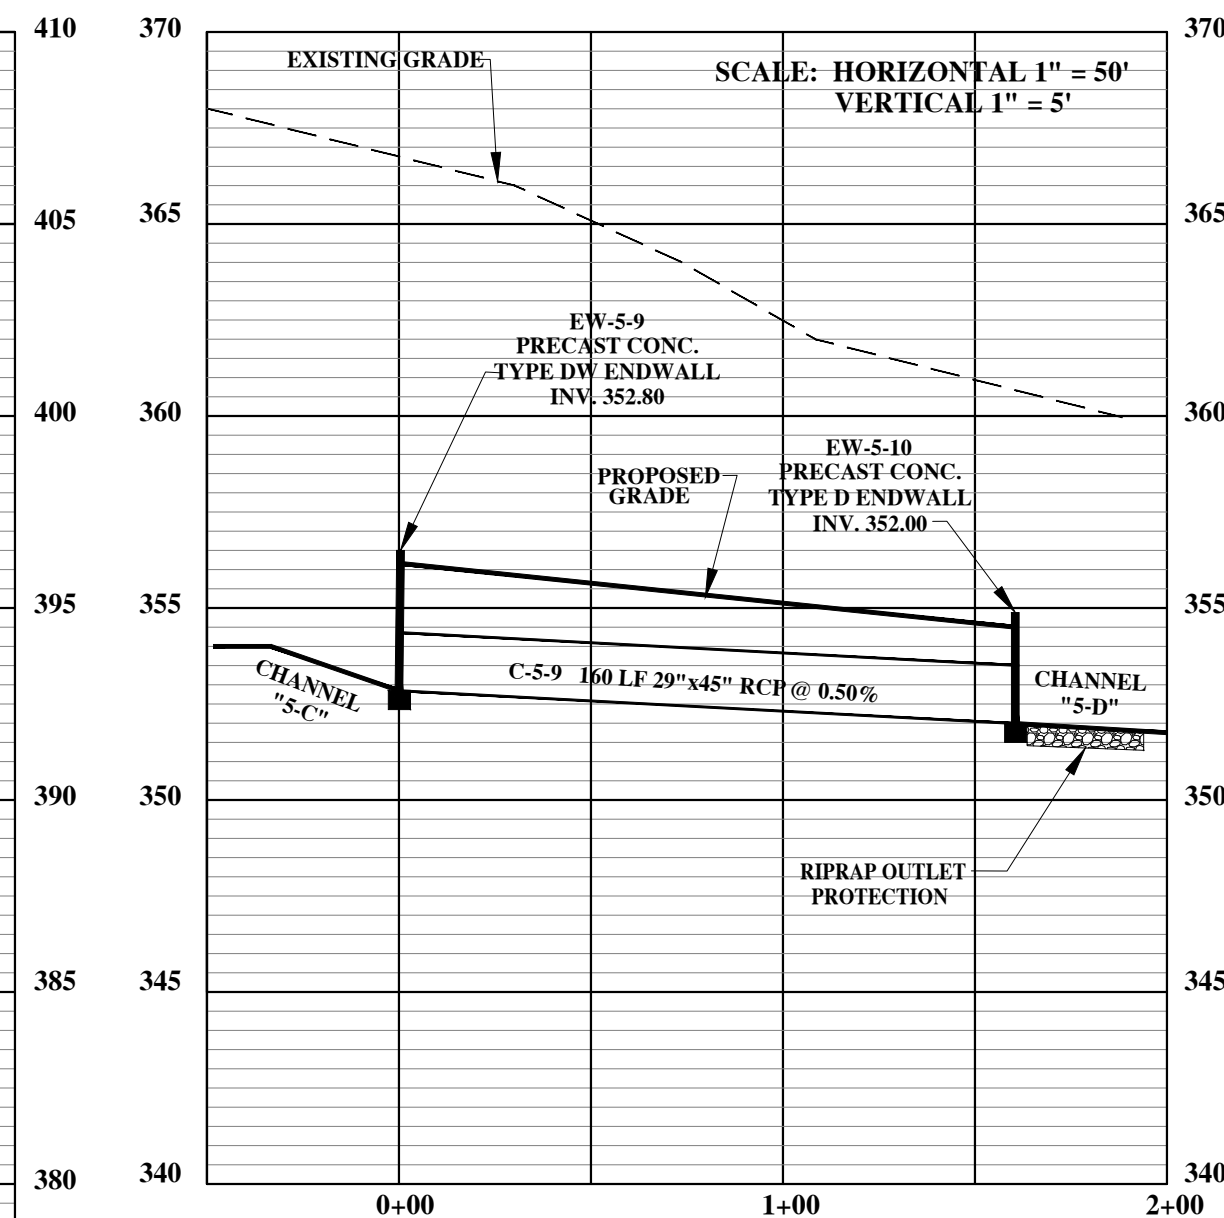

C-5-9 PROFILE

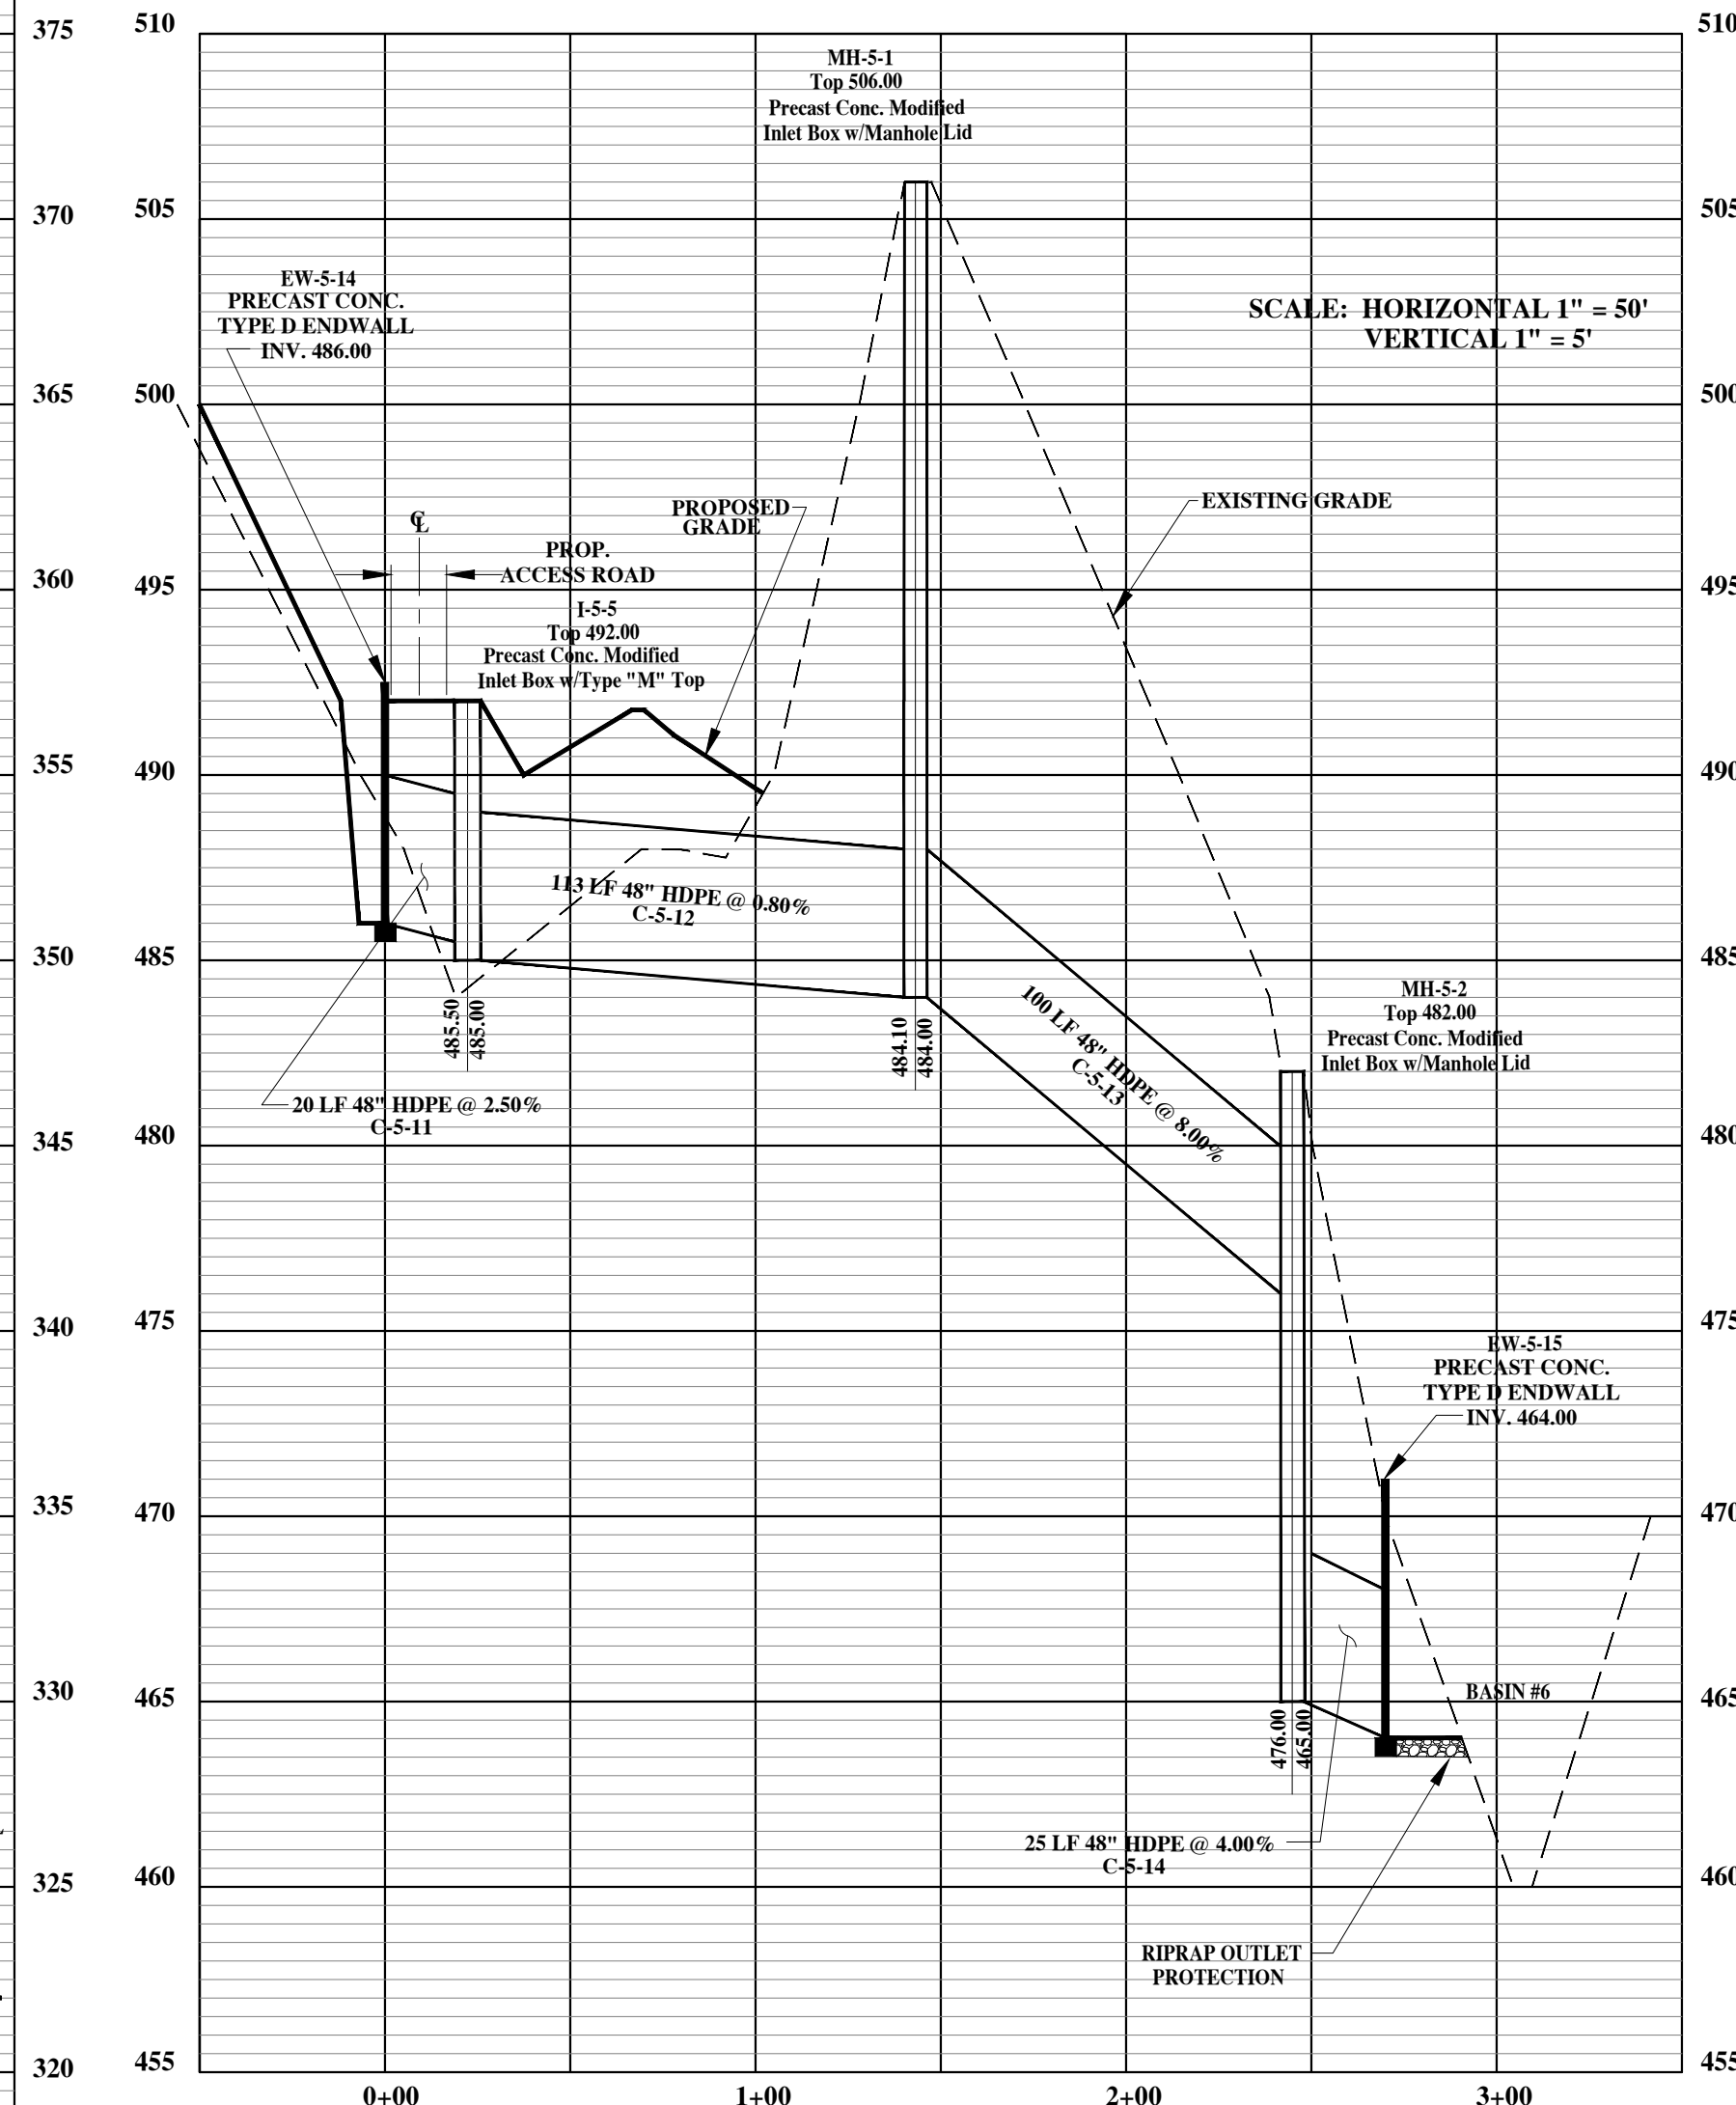

C-5-11 TO C-5-14 PROFILE



| NO. | REVISION | DATE |
|-----|----------|------|
|     |          |      |
|     |          |      |
|     |          |      |
|     |          |      |

POST CONSTRUCTION STORMWATER PROFILES  
NORTHAMPTON CO.  
PHASE V EXPANSION  
Bethlehem Landfill Company  
PENNSYLVANIA  
LOWER SAUCON TWP.

**MMI** martin and martin incorporated  
37 south main street suite A  
chambersburg, pennsylvania . 17201  
phone: (717) 264-6759

|                  |                 |
|------------------|-----------------|
| PROJ. NO. 1162.6 | DWN. BY: MSH/DB |
| DSEN. BY: JM     | CHK. BY: RMB    |

CADD FILE: 1162.6-PC-13.dwg  
DATE: 09/11/23  
SCALE: AS SHOWN  
DRAWING NO.

PC - 13